


Section 31 Township 10 Range 17 W

Well No. # 3 Hahn

Company Bay Petroleum

NORTH

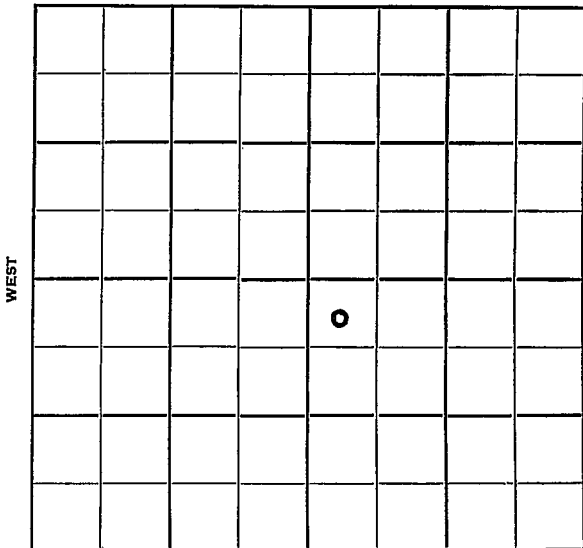

SOUTH

10

Sec. 31 Twp. 10 R. 17WWell No. #3 Hahn FarmBay Petroleum CompanyPickrell Drlg. Contractor

Burnett Pool


430 Ft. from N. Line

Ft. from S. Line

Ft. from E. Line

330 Ft. from W. Line

NW NW SE

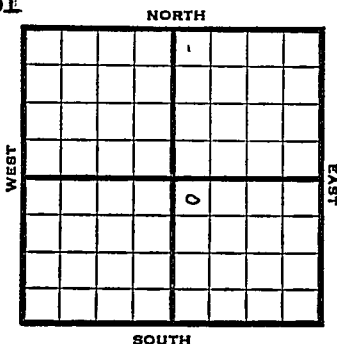

1952

Elev. 2058'

REPORT

7/30

Spud 7-24-52

8" @ 160'

Drlg. 2580'

8/6

Heeb. 3230

Tor. 3250

Lans. 3271

Cong. 3525

DST 3525-51, $\frac{1}{2}$ hr. 7' m 165#

Simp. dol. 3588 Arb. 3613-18 TD

5" @ 3615'

8/13

MICT

8/20

CO 3619' Fill up 1400' fluid $2\frac{1}{2}$ hrs.

S/15 BOPH plus 15% wtr. 900' off btm

8/27

NR

9/3

"

9/10

Spud 7-24-52 Oil Well TD 3619

8" @ 160 Heeb. 3230 Tor. 3250

Lans. 3271 Cong. 3525

DST 3525-51 opn $\frac{1}{2}$ hr. Rec. 7' mud

165# Simp. 3588 Arb. 3613

TD 3618 5" @ 3615 CO to 3619

FU 1400' fluid $2\frac{1}{2}$ hr. S/15 boph

15% wtr. Comp. 132 bopd 50% wtr.

COMPLETED

J. G. McGEHEE