

Rooks

Form 51--5M--7-39--Palace

Well No. #1 Kempe "A"

Company Bay Petroleum

Miscellaneous


14

SOUTH

KANSAS


Rooks

Sec. 31 Twp. 10 R. 17-WWell No. #1 Kempe "A" FarmBay Petr. Company

(Miscellaneous)

 Ft. from N. Line330 Ft. from S. Line990 Ft. from E. Line Ft. from W. Line

Elev. 2039

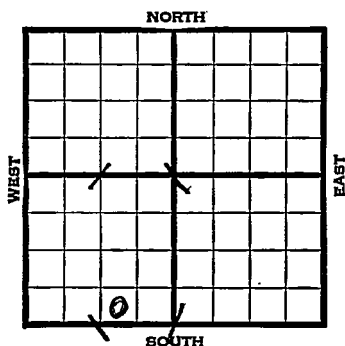

1939	REPORT
8/16	Rig.
8/24	Rotary.
8/31	Rigging up.
9/7	RU & SD.
9/14	" "
9/21	Drlg. 1140'
9/28	10 $\frac{3}{4}$ " - 1315' Drlg. 2547'
10/5	Lans. 3265' Drlg. 3550'
10/11	Arb. 3584' 7" - 3586'
	T.D. 3585' 2500' oil.
10/18	Arb. 3584'
	7" - 3586'
	T.D. 3588'
	1500 acid.
	Depthograph potential 4784 bbls.
	Maximum 3500 bbls.
	COMPLETED

Map No. 64 Sec. 31 Twp. 10 R. 17WWell No. 1 Kempe "A"Bay Petroleum

Company

Contractor

FIRST REPORT
SW SE SW**SECTION PLAT**

Ft. from N. Line

330

Ft. from S. Line

990

Ft. from E. Line

Ft. from W. Line

MISCELLANEOUS

Location _____

Rig up _____

Drilling and Remarks:

Rig**RECORD**

Cased _____ in., _____ ft.

Sand _____

Gas _____

Oil _____

Total Depth _____

PRODUCTION

1st 24 hrs. Nat. _____

1st 24 hrs. after shot _____

Gas _____ Cu. Ft.

Dry Hole _____

Abandoned _____

Date

AUG 16 1939

19

S. J. LEWIS

Scout

Map No. 64 Sec. 31 Twp. 10 R. 17WWell No. 1 Kemp'e "A"

Bay Petroleum

Company

Contractor

COMPLETED

SW SE SW


Ft. from N. Line

330 Ft. from S. Line990 Ft. from E. Line

Ft. from W. Line

MISCELLANEOUS

SECTION PLAT

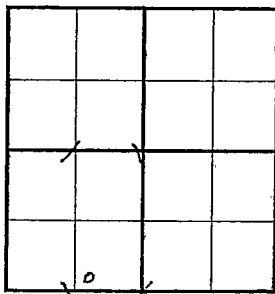

Location

Rig up

Drilling and Remarks:

*Cut & 3584**7" @ 3586**15.00 Acid**Sept. 10, 1938**4784**3500 Maximum*

RECORD

Cased _____ in., _____ ft.

Sand _____

Gas _____

Oil _____

Total Depth 3588

PRODUCTION

1st 24 hrs. Nat. _____

1st 24 hrs. after shot _____

Gas _____ Cu. Ft.

Dry Hole _____

Abandoned _____

Date

OCT 18 1939

19

S. J. LEWIS

Scout