


Section 31 Township 10 Range 17W

Well No. #1 E. Ridler "C"

Company Shell

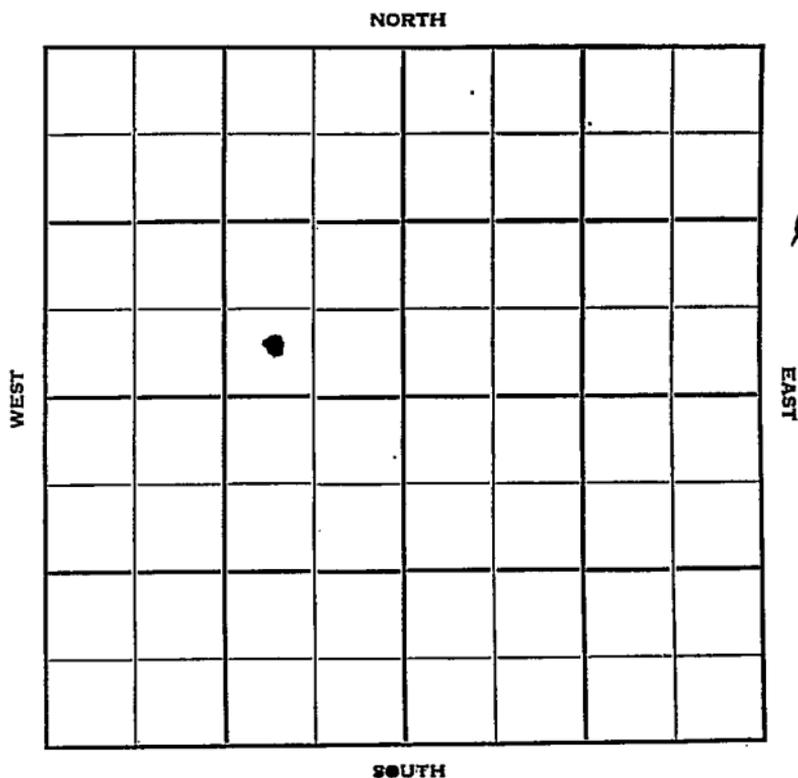

Rooks

KANSAS

Sec. 31 Twp. 10 R. 17W

Well No. #1 E. Ridler "C" Farm

Shell Company

Burnett Pool Contractor


_____ Ft. from N. Line

330 Ft. from S. Line

990 Ft. from E. Line

_____ Ft. from W. Line

SW SE NW

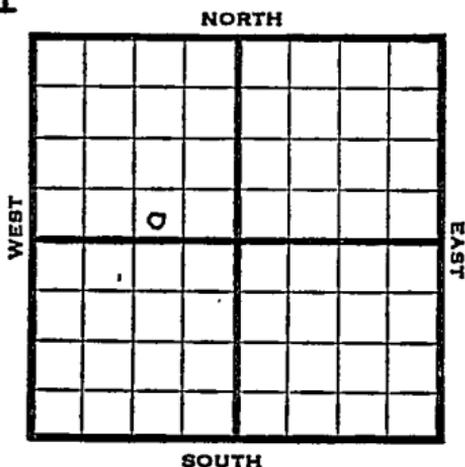

1952

Elev. 2089' REPORT

1/2
2/6

Location

Spud 1-3-52

Oil Well T^W 3657

8" @ 1381

Tor. 3293

Lans. 3317

Cong. 3570

Simp. 3625

Arb. 3655

TD 3657 4 1/2" @ 3656 CO to 3657

S/ 5 1/2 BF 5 1/2 hr. 48% oil 110A

S/ 6 1/2 BF 8 hr. 50% wtr. PB 3656

8/ 365-56 250 A S/ 5 BFPH 10 hr.

42% wtr. P/ 147 BO 27 BW 16 hr.

Comp. 65 BOPD 38 BW

COMPLETED


County Rooks State Kansas

Sec. 31 (Blk. Twp.) 10 (Sur. Rge.) 17W Map No.

Operator Shell

Well No. 1 Farm E. Ridler "C"

Elev. 2089 Location SW SE NW

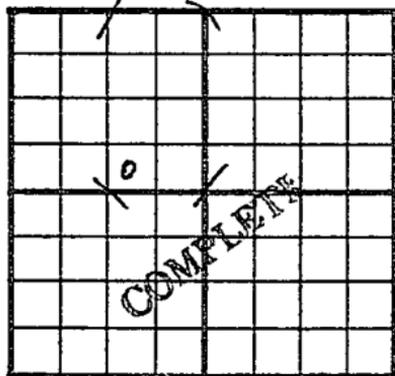

330 Ft. From S Line NW

990 Ft. From E Line Quarter

Ist. Report

Completion FEB 6 1952

Remarks Burnett Pool

Deek - Contr.

Spudding Date 1-3-52

Drlg. Data Oil well TD 3657

8" @ 1381 Tor. 3293 Lans. 3317

Cong. 3 570 Simp. 3625 Arb. 3 655

TD 3657 4 1/2" @ 3656 CO to 3657

S/ 5 1/2 bf 5 1/2 hr. 48% oil 110 A

S/ 6 1/2 bf 8 hr. 50% water PB 3656

8/ 3654-56 250 A S/ 5 bfph 10 hr.

42% water P/ 147 bo 27 bw 16 hr.

Comp. 65 bopd 38 bw

J. G. McGEHEE