


Section 31 Township 10 Range 17 W

Well No. # 2 Burnett "B"

Company Earl Wakefield

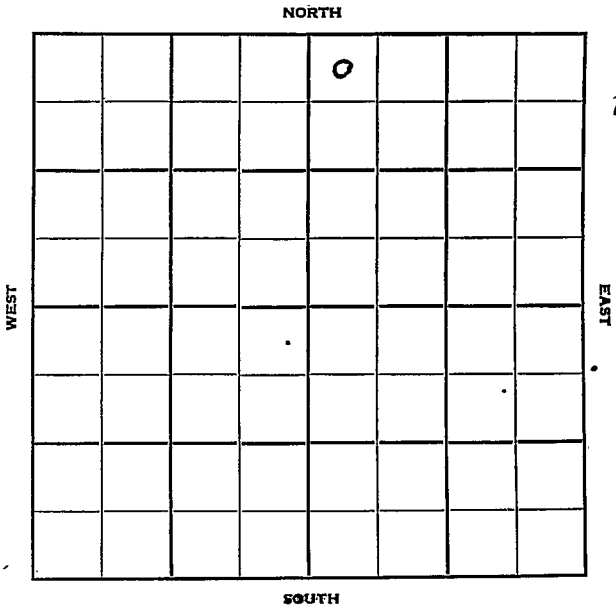

Sec. 31 Twp. 10 R. 17W

Well No. #2 Burnett "B" Farm

Earl Wakefield Company

Contractor

**Burnett Pool**


330 Ft. from N. Line

\_\_\_\_\_ Ft. from S. Line

\_\_\_\_\_ Ft. from E. Line

330 Ft. from W. Line

NW NW NE

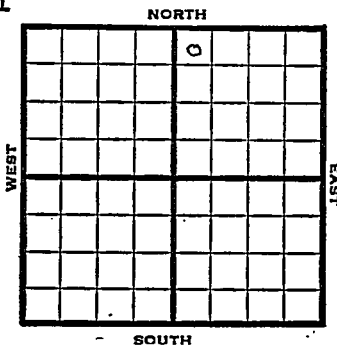

1952

Elev. 2042' REPORT

3/19

Location

3/25

"

4/1

RUR

4/9

8" @ 116'

Anhy 1330-70 TD 2616

Fishing drill pipe

4/16

Spud 4-2-52

D & A TD 3670' 8" @ 116

Anhy 1330-70' Lans. 3274' Cong. 3530

Simp. 3585' Arb. 3620'

TD 3670' D & A

**ABANDONED**



