


Section 31 Township 10 Range 17 W

Well No. # 2 Hahn

Company Bay Pet.

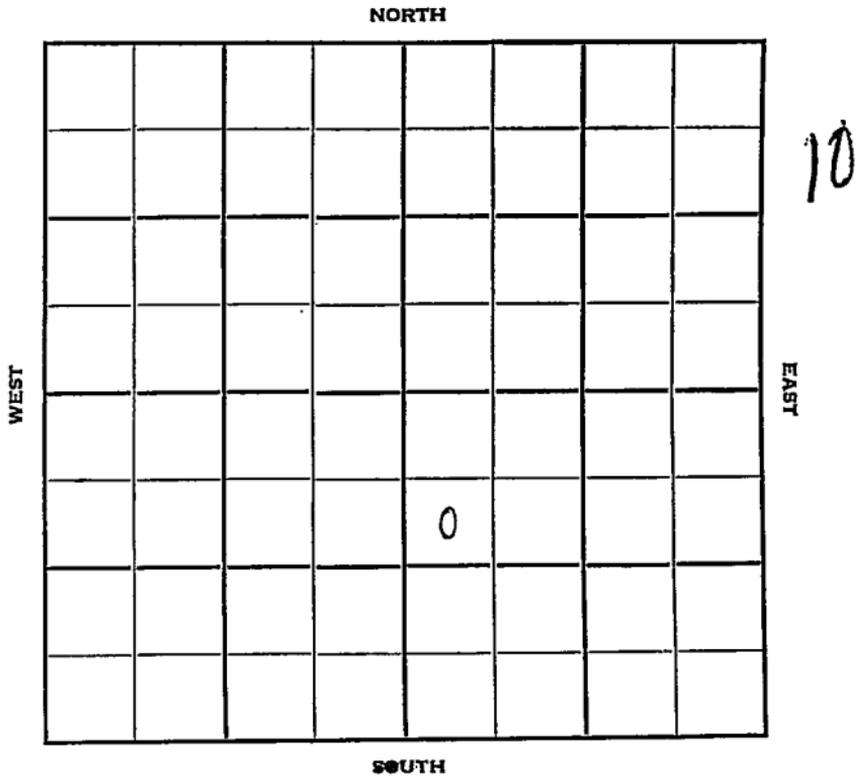

Sec. 31 Twp. 10 R. 17W

Well No. #2 Hahn Farm

Bay Pet. Company

Lindsley Contractor

Barnett


990 Ft. from N. Line

\_\_\_\_\_ Ft. from S. Line

\_\_\_\_\_ Ft. from E. Line

330 Ft. from W. Line

SW NW SE

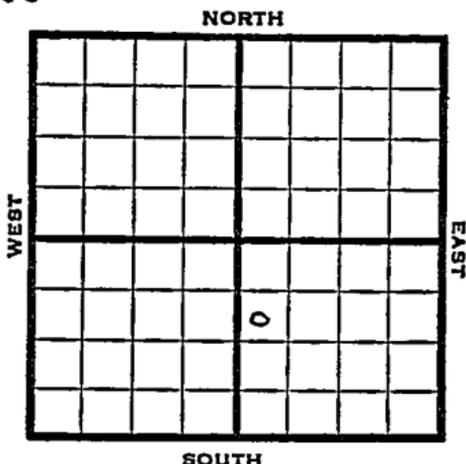

1951 Elev. 2075' REPORT

11/7 RUR

1952

1/16

Spud 11-7-51  
 Oil Well TD 3630'  
 8" @ 151  
 Anhy 1290                      Ians. 3290  
 DST 3349-66 open 1 hr. rec. 30' OCM  
 DST 3476-3519 open 1 hr. rec. 18' OCM  
 & SSO Arb. 3628-30 5" @ 3629 CO  
 to 3630 S/ 5 BOPH 4 hr. FU 2030' oil  
 15 GW 12 hr.  
 Comp. 28 BOPD 80% wtr.

**COMPLETED**



County \_\_\_\_\_ Rooks State **Kansas**

Sec. **31** (Blk.) **10** (Sur.) **17W** Map No. \_\_\_\_\_  
 (Twp.)

Operator **Bay Pet.**

Well No. **2** Farm **Hahn**

Elev. **2075** Location **SW NW SE**


**COMPLETE**

**990** Ft. From **N** Line **SE**

**330** Ft. From **W** Line **Quarter**

Ist. Report \_\_\_\_\_

Completion **JAN 16 1952**

Remarks **Barnett Pool**

**Lindsley - Contr.**

Spudding Date **11-7-51**

Drlg. Data **Oil well** **TD 3630**

**8" @ 151 Anhy 1290 Lans. 3290**

**DST 3349-66 open 1 hr. Rec. 30' ocm**

**DST 3476-3519 open 1 hr. Rec. 18' ocm**

**& SSO Arb. 3628-30 5" @ 3629 CO to**

**3630 S/ 5 boph 4 hr. FU 2030' oil**

**15 gw 12 hr. Comp. 28 bopd 80% water**

**J. E. TYRA**