

# KANSAS


Rooks

Form 51-5M-11-38-Palace

Section 31 Township 10 Range 17-W

Well No. #2 Riddler

Company Republic Natural Gas

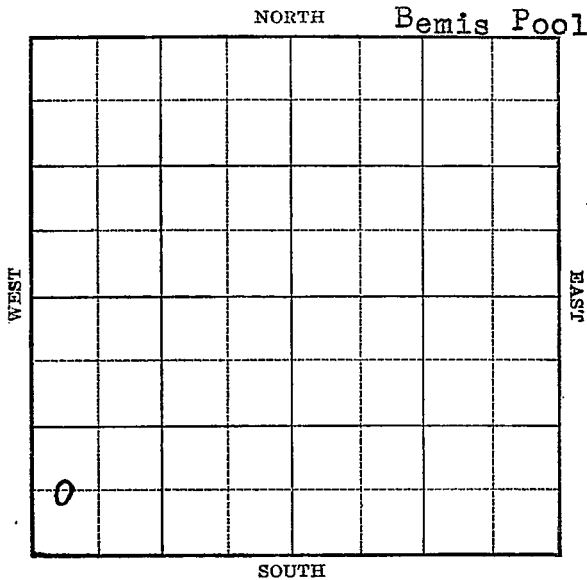



Map No. 64 Sec. 31 Twp. 10 R. 17WWell No. 2 RiddlerRepublic Natural Gas Company

Contractor

## FIRST REPORT

C  $W\frac{1}{2}$  SW SW


Ft. from N. Line

660 Ft. from S. Line

Ft. from E. Line

330 Ft. from W. Line

## SECTION PLAT

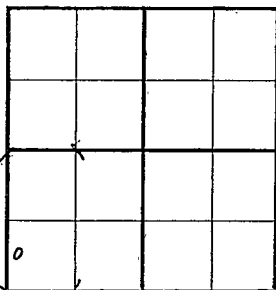

## BEMIS POOL

Location \_\_\_\_\_

Rig up \_\_\_\_\_

Drilling and Remarks:

Rotary

## RECORD

Cased \_\_\_\_\_ in., \_\_\_\_\_ ft.

Sand \_\_\_\_\_

Gas \_\_\_\_\_

Oil \_\_\_\_\_

Total Depth \_\_\_\_\_

## PRODUCTION

1st 24 hrs. Nat. \_\_\_\_\_

1st 24 hrs. after shot \_\_\_\_\_

Gas \_\_\_\_\_ Cu. Ft.

Dry Hole \_\_\_\_\_

Abandoned \_\_\_\_\_

Date

OCT 25 1939

19

S. J. LEWIS

Scout

Map No. 64 Sec. 31 Twp. 10 R. 17WWell No. 2 RiddlerRepublic Natl. Gas Company

Contractor

## COMPLETED

C  $W\frac{1}{2}$  SW SW       Ft. from N. Line660 Ft. from S. Line       Ft. from E. Line330 Ft. from W. Line

BEMIS POOL

## SECTION PLAT

|   |  |  |  |
|---|--|--|--|
|   |  |  |  |
|   |  |  |  |
|   |  |  |  |
|   |  |  |  |
| 0 |  |  |  |

Location                     Rig up                     

Drilling and Remarks:

*Art. 3601**5" @ 3603**Depthograph Rod  
15232**Maximum  
3800*

## RECORD

Cased            in.,            ft.Sand                     Gas                     Oil                     Total Depth 3604

## PRODUCTION

1st 24 hrs. Nat.                     1st 24 hrs. after shot                     Gas                      Cu. Ft.Dry Hole                     Abandoned                     

Date

DEC 6 1939 19S. J. LEWIS Scout