


Section 31 Township 10 Range 17 W

Well No. # 1 Riddler (A)

Company Republic Natural

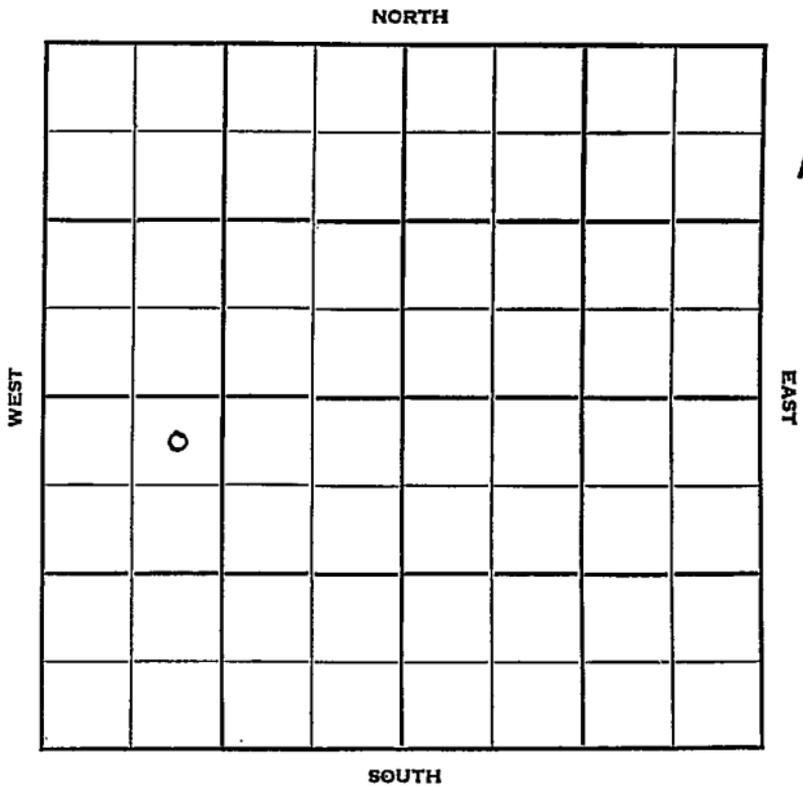

Rooks

KANSAS

Sec. 31 Twp. 10 R. 17 W

Well No. # 4 Riddler (A) Farm

Republic Natural Company

Gabbert-Jones Drlg. Contractor

Burnett


330 Ft. from N. Line

_____ Ft. from S. Line

_____ Ft. from E. Line

990 Ft. from W. Line

NE NW SW

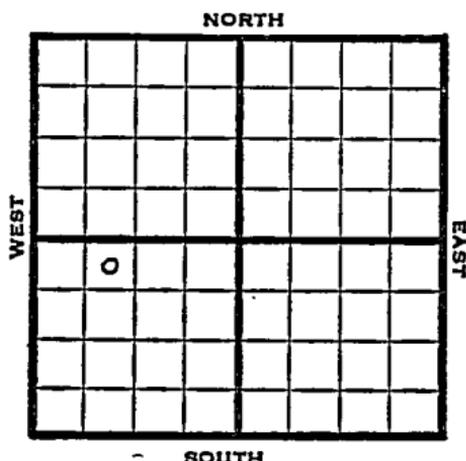

1951 Elev. 2076' REPORT

9/19 Spud 9-14-51
8" @ 360' Anhy 1345-90'
Drlg. 1550'

11/21 Spud 9-14-51
Oil well TD 3638' 8" @ 360
Anhy 1345-90' Heeb 3263' Lans. 3306'
DST 3456-3510 open 45 min. rec 140' SO
& WCM
Simp. 3608' Arb. 3629'
DST 3629-38 open 1/2 hr. rec 810' oil,
50' OCM
5" @ 3632' TD 3638' FU 1000' oil
1 hr. S/24 BOPH
Comp. 153 BOPD 10% water.

COMPLETED

County _____ Rocks _____ State **Kansas**

Sec. **31** (Bk. Twp.) **10** (Sur. Rge.) **17W** Map No. _____

Operator **Republic Natural Gas**

Well No. **4** Farm **Riddler "A"**

Elev. **2076** Location **NE NW SW**

330 Ft. From **N** Line **SW**

990 Ft. From **W** Line **Quarter**

1st. Report _____

Completion **NOV 21 1951**

Remarks **Burnett Pool**

Gabbert-Jones - Contr.

Spudding Date **9-14-51**

Drilg. Data **Oil well** TD **3638**

8" @ 360 Anhy **1345-90** Heeb. **3263**

Lans. **3306** DST **3456-3510** open **45 min.**

Rec. **140'** so & wcm Simp. **3608**

Arb. **3629** DST **3629-38** open $\frac{1}{2}$ hr.

Rec. **810'** oil **50'** ocm **5" @ 3632**

TD **3638** FU **1000'** oil **1 hr.** S/ **24 boph**

Comp. **153 bopd** **10%** water

J. E. TYRA