


Section 31 Township 10 Range 17W

Well No. #5 Kempe "A"

Company Bay Petroleum Co.

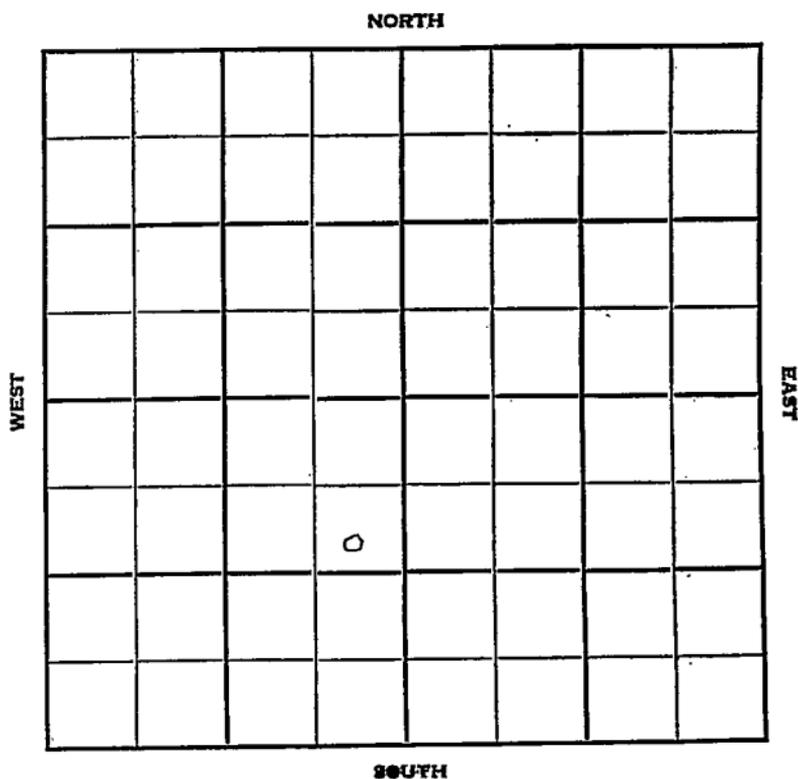

Rooks

KANSAS

Sec. 31 Twp. 10 R. 17 W

Well No. # 5 Kempe "A" Farm

Bay Petroleum Co. Company

Pickrell Drlg. Contractor


1100 Ft. from N. Line

_____ Ft. from S. Line

330 Ft. from E. Line

_____ Ft. from W. Line

SE NE SW

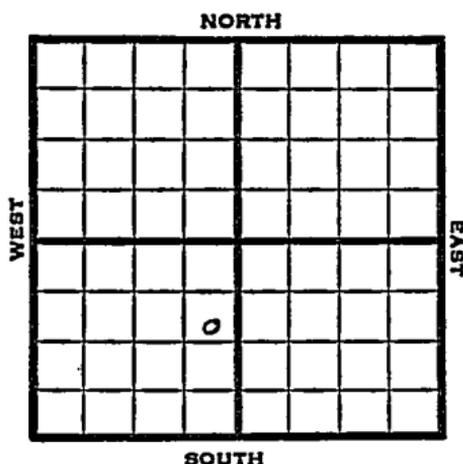

1951

Elev. 2082' REPORT

9/5

Spud 8-24-51
8" @ 161 Heeb 3254' Tor. 3273'
KC 3295'
DST 3457-3503 open 70 min. rec 130'
O & GCM
Cong 3551' Arb. 3633-37' TD
5" @ 3634'

10/24

Spud 8-24-51
OIL WELL TD 3637
8" @ 161'
Heeb 3254 Tor. 3273
KC 3295
DST 3457-3503 open 70 min. rec.
130' O&GCM
Cong. 3551 Arb. 3633-37
5" @ 3634 CO to 3637
FU 1500' wtr. Sq. off
DC to 3637 FU 200' fluid 50% oil
B/ 9 BO 16 BWPB 500 A S/ 79
BW 25 BO 4 hr.
Comp. 91 BOPD 73% wtr.

COMPLETED

