


Rooks

Section 31 Township 10 Range 17W

Well No. #1 Hahn

Company Bay Petroleum

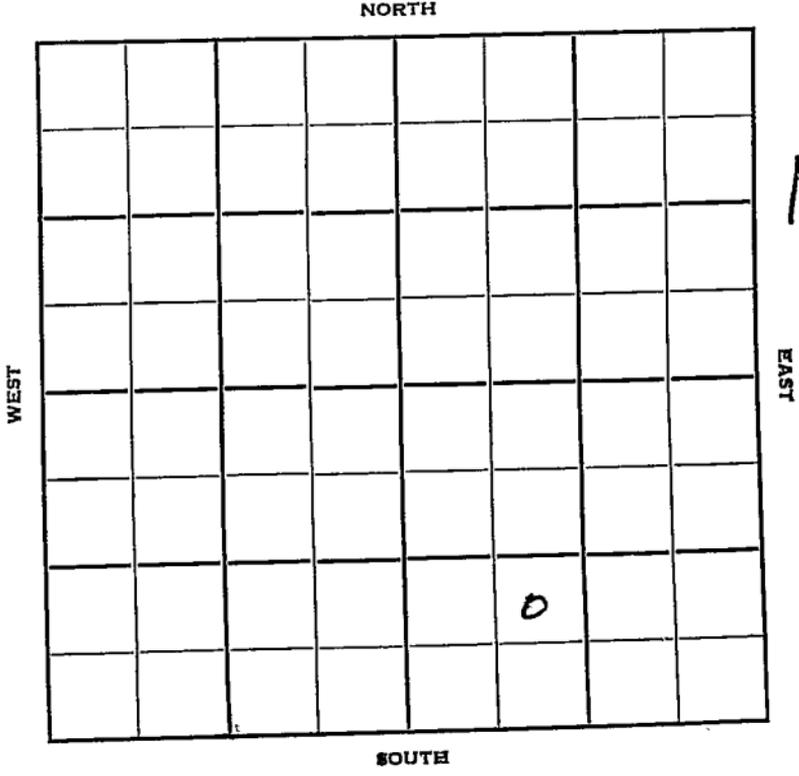

Sec. 31 Twp. 10 R. 17 W

Well No. # 4 Hahn Farm

Bay Pet. Company

Pickrell Drlg. Contractor

NW Grenett Pool

Ft. from N. Line

NORTH

990


Ft. from S. Line

Ft. from E. Line

990

Ft. from W. Line

NE SW SE

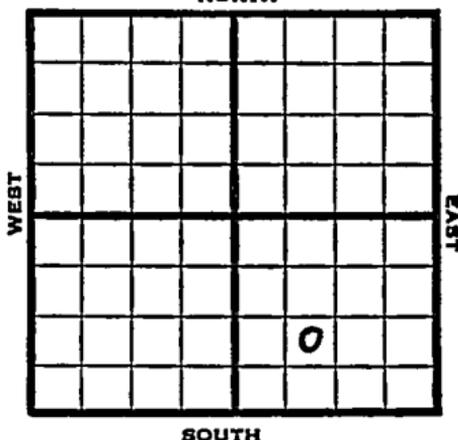

1953 *ELV 2070* REPORT

3/18 Spud 3-12-53
8" @ 160 Anhy 1345'
Drlg. 3020'

3/26 Top 3025, Heeb 3251, Tor 3273,
Lans 3293
DST 3330-68, 30' M, 520# 15"
DST 3452-99, 1 hr., 33' M, 970#
Cong 3547, Simp 3608, Arb 3631,
DST 3632-34, 1 hr., 840' oil,
60' OCM, 860#, FFP 370, -RTD 3634
5" @ 3632

4/2 CO 3634' FU 1800' fluid 5 hrs.
S/9 BO plus 9 BWPH 5 hrs.

4/9 NR

4/16 "

4/23 NR

4/30 "

5/6 Spud 3-12-53 Oil well TD 3634
8" @ 160 Anhy 1345 Top 3025
Heeb 3251 Tor 3273 Lans 3293
DST 3330-68 rec 30' mud 520#
DST 3452-99 open 1 hr rec 33' mud 970#
Cong 3547 Simp 3608' Arb. 3631'

OVER

1953

5/6

(Information continued)

DST 3632-34, open 1 hr, rec 840'

oil, 60' OCW 860# TD 3634

5" @ 3632 CO to 3634 FU 1800' fluid

5 hr. S/9 BO 9 BWP 5 hr.

Comp. 60 BOPD 84% wtr.

COMPLETED

