

Section 31 Township 10 Range 17 W

Well No. # 4 Kempe

Company Bay Pet.

NORTH

		0					

11

WEST

EAST

SOUTH

Rooks

KANSAS

Sec. 31 Twp. 10 R. 17 W ✓

Well No. # 4 Kempe "A" Farm

Bay Pet. Company

Contractor

330 Ft. from N. Line


Ft. from S. Line

990 Ft. from E. Line

Ft. from W. Line

NW NE SW

Shell Dry Hole Money

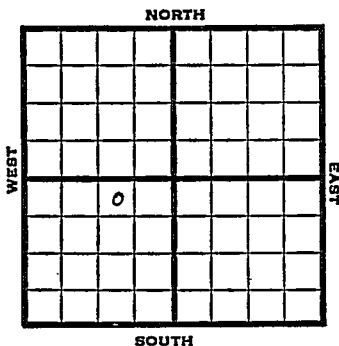

1951

Elev. 2077'

REPORT

7/11

R U R

9/12

Spud 7-9-51 Oil well TD 3637'
 8" @ 140' Top 3032'
 DST 3213-36 open 1/2 hr. rec 690' SW
 Heeb 3255' Lans. 3297'
 DST 3330-43 open 40 min. rec 1280'
 water.
 DST 3538-48 open 45 min. rec 90' SW
 Cong. 3551'
 DST 3628-36 open 45 min. rec 300' oil
 30' OCM
 Arb. 3633-37 5" @ 3634 TD 3637'
 S/3 BOPH
 Comp. 124 BOPD

COMPLETED

