


FORM 51 25M 3-49 PETROL Rooks

Section 31 Township 10 Range 17W

Well No. #5 Ridder (A)

Company Republic Natural Gas

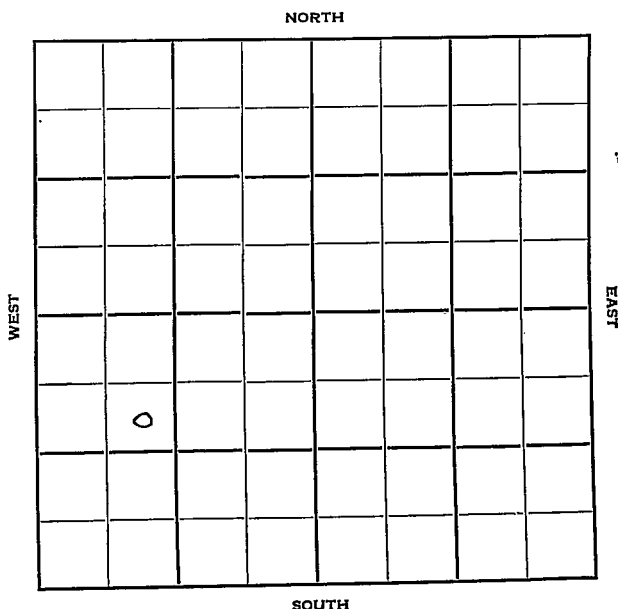

Rooks

KANSAS

Sec. 31 Twp. 10 R. 17W1

Well No. #5 Ridder (A) Farm

Republic Natural Gas Company

Gabert & Jones Contractor


990 Ft. from N. Line

 Ft. from S. Line

 Ft. from E. Line

990 Ft. from W. Line

SE NW SW

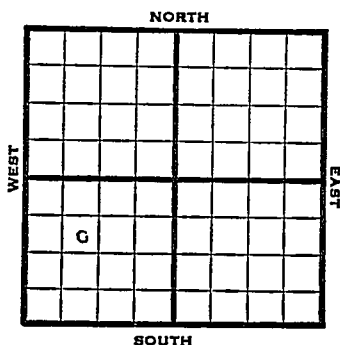

1952 Elev. 2070' REPORT

2/13 Spud 2-8-52
8" @ 331' WOC

2/20 Drlg. 3295'

3/5 CO to 3632'
Fill up 2350' oil S/96 BO 3 hrs.
tubing & rods.

3/12 No report

3/19 "

3/25 P 137 BOPD & 44 BWPD

4/1 NR

4/9 "

4/16 Spud 2-8-52
Oil well TD 3632' 8" @ 331'
Heeb 3251' Lans. 3293'
DST 3483-3514 open 1 hr. rec 60' HOCM
Cong. 3540' Arb. 3625'
DST 3626-32 open 20 min. rec 930' free
oil. TD 3632' 5" @ 3627' GO to
3632' FU 2350' oil S/96 BO 3 hr.
Comp. 82 BOPD 51% water.

COMPLETED



Sec. 31 (Blk. Twp.) 10 (Sur. Rge.) 17W Map No.

Operator Republic Natural Gas

Well No. 5 Farm Ridder "A"

Elev.	2070	Location	SE NW SW
-------	------	----------	----------

0

COMPLETE

990 Ft. From N Line SW

990 Ft. From W Line Quarter

1st. Report

Completion APR 16 1952

Remarks

Gabbert & Jones - Contr.

Spudding Date **2-8-52**

Drilg. Data Oil well TD 3632

8" @ 331 Heeb. 3251 Lans. 3293

DST 3483-3514 open 1 hr. Rec. 60' hoom

Cong. 3540 Arb. 3 625 DST 3626-32

open 20 min. Rec. 930' free oil TD 3632

5" @ 3627 CO to 3632 FU 2350' oil

S/ 96 bo 3 hr. Comp. 82 bopd 51% water

J. G. McGEHEE