


Section **31** Township **10** Range **17W**

Well No. **#7 Kempe (A)**

Company **Bay Pet.**




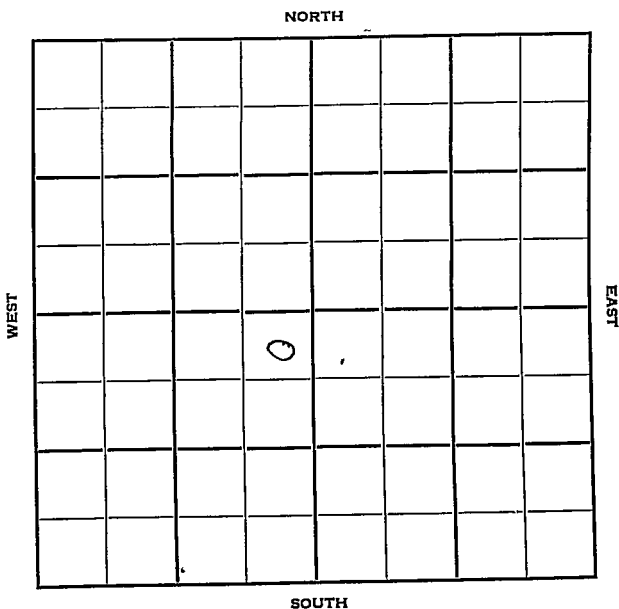

Sec. 31 Twp. 10 R. 17W

Well No. #7 Kempe A Farm
Bay Pet. Company
B & B - Contr. Contractor

330' Ft. from N. Line
 _____ Ft. from S. Line
330' Ft. from E. Line
 _____ Ft. from W. Line

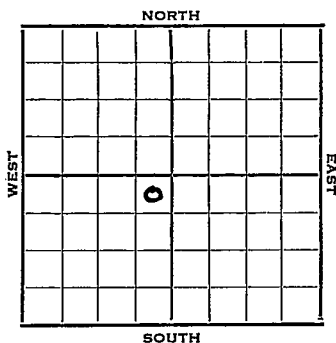

NE NE SW

1952 Elev. 2088' REPORT

9/17 MIR
 9/24 8" @ 159 Anhy 1360'
 Drlg. 2385'

10/1 Heeb 3263, Tor 3279, Lans 3303,
 Cong. 3557
 DST 3560-90 1/2 hr., 5' M 270#
 Arb 3645

10/8 RTD 3734
 4 1/2" @ 3728'

10/15 CO to 3731, 12/3652-55, 115 BWPB
 & SSO, SP 3648, 6/3645-47, S/2 BOPB
 25% W

10/22 NR
 10/29 NR

11/5 Spud 9-17-52
 Oil Well TD 3731' 8" @ 159
 Anhy 1360 Heeb. 3263
 Tor. 3279 Lans. 3303
 Cong. 3557
 DST 3560-90 open 1/2 hr. rec. 5' mud
 270# Arb. 3645 TD 3731
 4 1/2" @ 3728' CO to 3731
 12/ 3652-55 115 bwph & SSO
 SP 3648' 6/ 3345-47 S/ 2 boph
 25% wtr.
 Comp. 37 bopd 43% wtr.

COMPLETED

