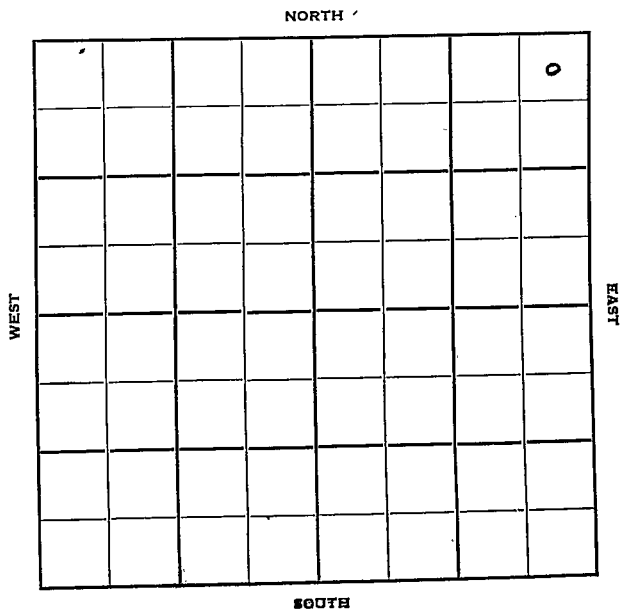


Section 31 Township 10 Range 18 WWell No. # 1 - RichardsCompany Lowell - Gist

Rooks

KANSAS

Sec. 31 Twp. 10 R. 18W ✓

Well No. #1 Richards Farm

Lowell-Gist Company

Contractor


330' Ft. from N. Line

Ft. from S. Line

330' Ft. from E. Line

Ft. from W. Line

NE NE NE

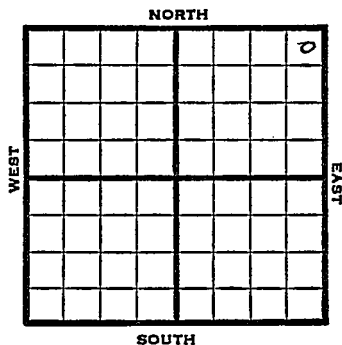

1950

Elev. 2039' REPORT

5/17

Location

5/31

10" @ 115'

Heeb 3246'

BKG 3520'

Toronto 3264'

Cong. 3539'

Lans. 3287'

Simp 3632'

DST 3370-76' opn 30'min Arb. 3650'

Rec. 255' wtr

TD 3696'

D&A

ABANDONED

Kansas

Map No. _____ Sec. 31 Twp. 10 R. 18WWell No. 1 RichardsLowell-Gist

Company

Contractor

NE NE NE

SECTION PLAT

330 Ft. from N. Line

_____ Ft. from S. Line

330 Ft. from E. Line

_____ Ft. from W. Line

			0
FIRST REPORT			

Rocks

Location X

Rig up

Drilling and Remarks:

RECORD

Cased _____ in., _____ ft.

Sand _____

Gas _____

Oil _____

Total Depth _____

PRODUCTION

1st 24 hrs. Nat. _____

1st 24 hrs. after shot _____

Gas _____ Cu. Ft.

Dry Hole _____

Abandoned _____

Date

MAY 17 1950

19

J. E. TYRA

Scout

Map No. _____ Sec. 31 Twp. 10 R. 18WWell No. 1 RichardsLowell-Gist Company

Contractor


NE NE NE .

F/ 2039
SECTION FLAT330 Ft. from N. Line

_____ Ft. from S. Line

330 Ft. from E. Line

_____ Ft. from W. Line

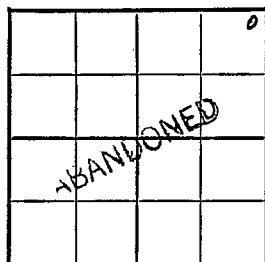

Rocks .

Location _____

Rig up _____

Drilling and Remarks:

10" @ 115Neub. 3246Gronto 3264Lans. 3287DST 3370-76Open 30 minRec. 255' water

RECORD

Cased _____ in., _____ ft.

Sand _____

Gas _____

Oil _____

Total Depth 3696

PRODUCTION

1st 24 hrs. Nat. _____

1st 24 hrs. after shot _____

Gas _____ Cu. Ft.

Dry Hole _____

Abandoned _____

Date

MAY 31 1950J. E. TYRA Scout

