

Rooks

FORM 51 25M 3-49 PETROL

**KANSAS**

Section 31 Township 10 Range 19W

Well No. #1 Schonholer

Company Heathman Drlg.

NORTH

|  |   |  |  |  |  |  |   |
|--|---|--|--|--|--|--|---|
|  |   |  |  |  |  |  |   |
|  |   |  |  |  |  |  |   |
|  | 1 |  |  |  |  |  |   |
|  |   |  |  |  |  |  |   |
|  |   |  |  |  |  |  | 0 |
|  |   |  |  |  |  |  |   |
|  |   |  |  |  |  |  |   |
|  |   |  |  |  |  |  |   |

WEST

EAST

SOUTH

Sec. 31 Twp. -10 R. 19W

Well No. #1 Schonholer Farm

Heathman Drlg. Company

Wildcat

Contractor


330' Ft. from N. Line

Ft. from S. Line

330' Ft. from E. Line

Ft. from W. Line

NE NE SE

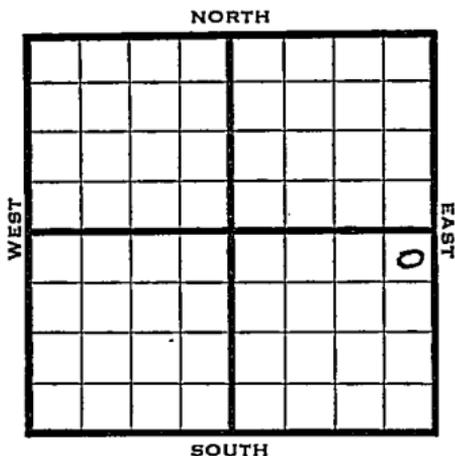

1950

Elev 2148'

REPORT

2/8 Location

3/8 TD 3780'

8" @ 121

Lans 3425'

Simp 3728'

Arb 3750'

D&A

Aband.

**ABANDONED**

Map No. \_\_\_\_\_ Sec. 31 Twp. 10 R. 19W

Well No. 1 Schontholer

\_\_\_\_\_ Heathman Drlg. \_\_\_\_\_ Company

\_\_\_\_\_ Contractor

NE NE SE

SECTION PLAT

330 Ft. from N. Line

\_\_\_\_\_ Ft. from S. Line

330 Ft. from E. Line

\_\_\_\_\_ Ft. from W. Line



Rooks County

Location X

Rig up \_\_\_\_\_

Drilling and Remarks:

RECORD

Cased \_\_\_\_\_ in., \_\_\_\_\_ ft.

Sand \_\_\_\_\_

Gas \_\_\_\_\_

Oil \_\_\_\_\_

Total Depth \_\_\_\_\_

PRODUCTION

1st 24 hrs. Nat. \_\_\_\_\_

1st 24 hrs. after shot \_\_\_\_\_

Gas \_\_\_\_\_ Cu. Ft.

Dry Hole \_\_\_\_\_

Abandoned \_\_\_\_\_

Date

FEB 8 1950

19

J. E. TYRA

Scout

Kansas

Map No. \_\_\_\_\_ Sec. 31 Twp. 10 R. 19W

Well No. 1 Schontholer

Heathman Drlg. Company

Contractor

NE NE SE

*EI. 2148*  
SECTION PLAT

330 Ft. from N. Line

\_\_\_\_\_ Ft. from S. Line

330 Ft. from E. Line

\_\_\_\_\_ Ft. from W. Line

|           |  |  |   |
|-----------|--|--|---|
| ABANDONED |  |  |   |
|           |  |  |   |
|           |  |  | e |
|           |  |  |   |

Rooks County

Location \_\_\_\_\_

Rig up \_\_\_\_\_

Drilling and Remarks:

*8' @ 121*  
*Lans 3425*  
*Simp 3728*  
*arb 3750*  
*DVA*

RECORD

Cased \_\_\_\_\_ in., \_\_\_\_\_ ft.

Sand \_\_\_\_\_

Gas \_\_\_\_\_

Oil \_\_\_\_\_

Total Depth 3780

PRODUCTION

1st 24 hrs. Nat. \_\_\_\_\_

1st 24 hrs. after shot \_\_\_\_\_

Gas \_\_\_\_\_ Cu. Ft.

Dry Hole \_\_\_\_\_

Abandoned \_\_\_\_\_

Date

MAR 8 1950 19

J. E. TYRA

Scout