


Rooks

DX 78-1

Section 31 Township 10 Range 20 W

Well No. #1 Schneider

Company Cities Service

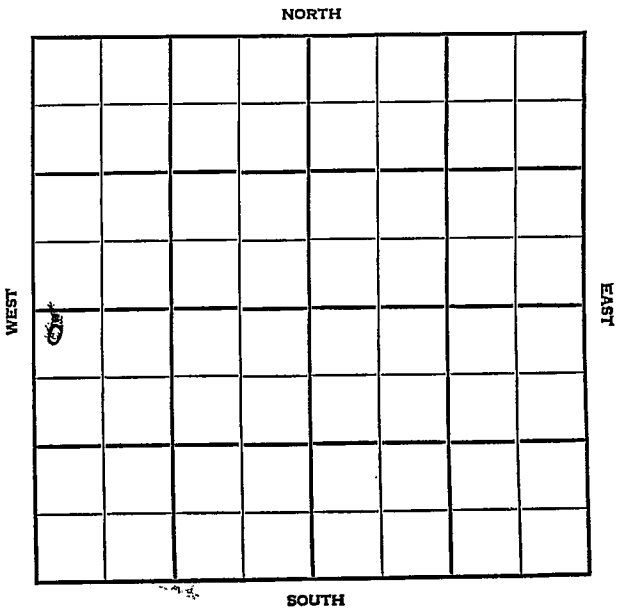

Rooks

KANSAS

SEC.	TWP.	R..
31	10	20W

WELL NO.

#1 Schneider

FARM

COMPANY

Cities Service

CONTRACTOR

L & J

SW White


_____ Ft. from N. Line

_____ Ft. from S. Line

_____ Ft. from E. Line

_____ Ft. from W. Line

NW NW SW

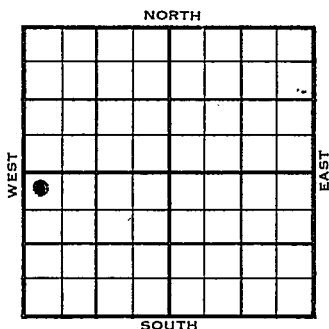

1955	ELEVATION	REPORT
------	-----------	--------

8/3

Location

FIRST REPORT

9/28

En Comm 8-7-55

8 5/8" @ 204/175

Tp 3136

H 3336

Dodge 3358

L 3370

BKC 3618

Chert 3641

A 3675

TD 3677

DST 3502-20 open 1/2 hr Rec 7' mud

90/30" DST 3525-45 open 1 hr Rec

663' oil 180' smco 1160/30"

DST 3546-75 open 1 hr Rec 85' ocm

1245/30" 5 1/2" @ 3676/175 DD 3680

FU 2910' oil 9 hr P/427 bo 24 hr

Comp 242 bopd

COMPLETED

County Rooks Elev. 2116
 Sec. 31 Twp. 10 Rge. 20W
 Company Cities Service
 Farm Name Schneider No. 1

TOPS	DEPTH	LOG	DATUM	Loc. in Sec.
Anh.				NW NW SW
Top.	3136		1020	
H.	3336		1220	
Fr. Dodge	3358		1242	
Dg.				
BL.				
L.	3370		1254	Geol.
K.C.				Contr.
B.K.C.	3618		1502	
Ce.				
C. <u>Chen</u>	3641		1525	L & J
M.				Pool
M.				SW White
K.				
Mz.				
Ma.				
V.				
S.				
S.				
A	3675		1559	
R.				
Pe.				
G.				
T.D.	3677			

Date Comm. 8-7-55 SEP 28 1955
8 5/8" @ 204/175 DST 3502-20 open $\frac{1}{2}$ hr.
 Rec. 7' mud 90/30" DST 3525-45 open
 1 hr. Rec. 663' oil 180' smco 1160/30"
 DST 3546-75 open 1 hr. Rec. 85' ocm
1245/30" 5 1/2" @ 3676/175 DD 3680
 FU 2910' oil 9 hr. P/ 427 bo 24 hr.
 Comp. 242 bopd