


Section 31 Township 10 Range 20 W

Well No. #1 Schneider

Company Francis Oil & Gas

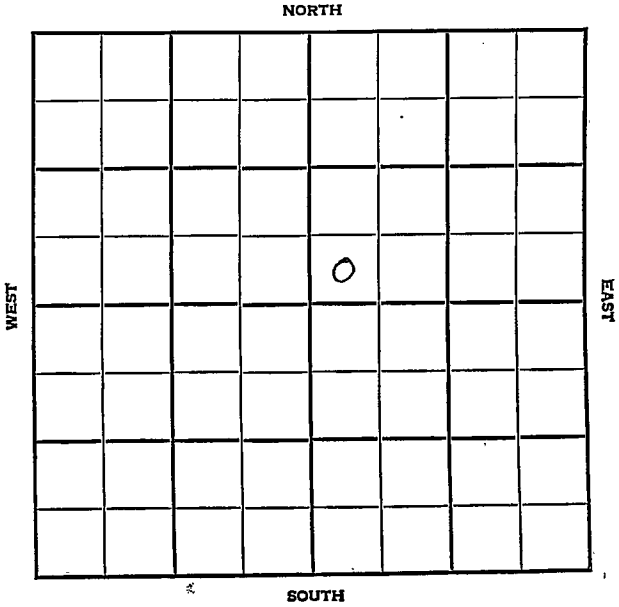

Rooks

KANSAS

SEC.	TWP.	R.
31 - -	10	20W

WELL NO.

#1 Schneider

FARM

COMPANY

Francis Oil & Gas

CONTRACTOR

Ammer

SW White


_____ Ft. from N. Line

_____ Ft. from S. Line

_____ Ft. from E. Line

_____ Ft. from W. Line

SW SW NE

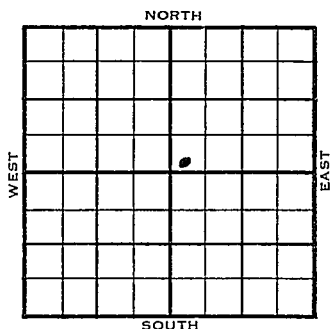

Magnolia AC

1955	ELEVATION 2107'	REPORT FIRST REPORT
------	--------------------	-------------------------------

8/10

MIR

8-24

8 5/8" @ 206/175

DST 3414-45 open 1 hr. rec. 6' mud, 50#

DST 3520-73, open 1 hr. rec. 70' wm 875#

DST 3575-3615, open 1 hr. rec. 10' mud 0#

DST 3697-3701 open 35 min. rec. 6' mud
300/20"DST 3701-10 open 1 hr. rec. 30' vsocm
430# D & A

Anh 1575, H. 3354, 1247, H. 3354, 1247,

Tr. 3377, 1270, L. 3394, 1287, B.K.C. 3618,

1511, C. 3647, 1540, A 3701, 1594,

T.D. 3710

ABANDONED

County Rooks Elev. 2107
 Sec. 31 Twp. 10 Rge. 20W
 Company Francis Oil & Gas
 Farm Name Schneider No. 1

TOPS	DEPTH	LOG	DATUM	Loc. in Sec.
Anh.	1575			SW SW NE
TP.				
H.	3354		1247	
Tr.		3377	1276	
Dg.				
BL.				
L.		3394	1287	Geol.
K.C.				Contr.
B.K.C.	3618		1571	Armer
Ce.				
C.	3647		1540	Pool SW White
M.				
M.				
K.				
Mz.				
Me.				
V.				
S.				
S.				
A.	3701		1594	<div style="border: 1px dashed black; width: 100%; height: 100%; display: flex; align-items: center; justify-content: center;"> ABANDONED </div>
R.				
PE.				
G.				
TD.	3710			

Date Comm. 8-11-55 AUG 24 1955
8 5/8" @ 206/175 DST 3414-45 open 1 hr.
Rec. 6' mud 50# DST 3520-73
open 1 hr. Rec. 70' wm 875#
DST 3575-3615 open 1 hr. Rec. 10' mud
0# DST 3697-3701 open 35 min.
Rec. 6' mud 300/20" DST 3701-10
open 1 hr. Rec. 30' wscm 130#
 D & A

Co. No. Sec. T. R.