


Section 31 Township 10 Range 20 W

Well No. #2 Theodore Schneider

Company Magnolia Pet.

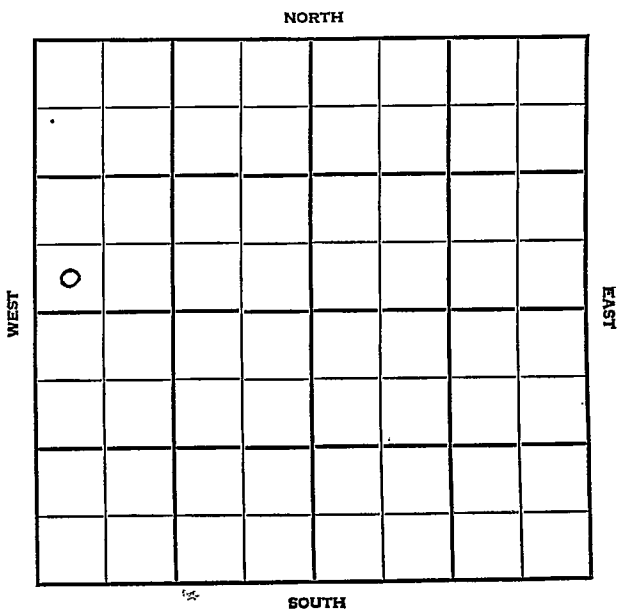

County Rooks Elev. _____
 Sec. 31 Twp. 10 Rge. 20W
 Company Magnolia Pet.
 FarmName Theodore Schneider No. 2

TOPS	DEPTH	LOG	DATUM	Loc. in Sec.
Anh.				SW SW NW
Tp.				
H.				
Tr.				
Dg.				
Bl.				
L.				Geol. _____
K.C.				Contr. _____
B.K.C.				
Ce.				
C.				
M.				Pool _____
Mz.				SE Laura
Me.				
V.				
S.				
S.				
A.				
R.				
PE.				
G.				
T.D.				

0
FIRST REPORT
 OCT 5 '55

Date Comm. _____
 Location _____

(Handwritten mark)

Co.
Lse.
No.
Sec.
T.
R.

County Rocks Elev. 2135
 Sec. 31 Twp. 10 Rge. 20W
 Company Magnolia Pet.
 Farm Name Theodore Schneider No. 2

TOPS	DEPTH	LOG	DATUM	Loc. in Sec.
Anh.				SW SWNW
Tp.	<u>3170</u>		<u>1035</u>	
H.	<u>3361</u>		<u>1226</u>	
Tr.				
Dg.				
Bl.				
L.	<u>3404</u>		<u>1269</u>	Geol.
K.C.				Contr.
B.K.C.				
Ce.				
C.				
M.				Pool
M.				<u>SE Laura</u>
K.				
Mz.				
Mo.				
V.				
S.				
S.				
A.	<u>3699</u>		<u>1564</u>	COMPLETE
R.				
PE.				
G.				
T.D.	<u>3785</u>			

Date Comm. 10-12-55 NOV 9 1955

9 5/8" @ 280/225 DST 3177-3215

open 1 hr. rec. 170' msW 1080/20"

DST 3580-3605 open 1 hr. rec. 60'

ocm 165' ho & gcm 20' free oil

1160/20" DST 3690-3708 open 1 hr.

rec. 34' mco 10' free oil 186' m &

gco 870/20" 5 1/2" @ 3781/175 CO to

3757 12/ 3746-49 B/ 14 ho 12 hr.

OVER

SP 3737 20/ 3731-36 1/ 3726-28

1/ 3720-22 S/-50 bo 11 hr.

CO to 3757 SP 3718 8/ 3712-11

16/ 3705-09 8/ 3699-3701 S/ 72 bo

9 hr. CO to 3757 - Comp. 251 bopd

_____	Misc.
_____	Pierce Map
_____	France Map
_____	Tracings
_____	Land Wall Map
_____	Land Small Map
_____	Scout Cards

W. W. W.

NOV 17 1955