5

SIDE ONE

STATE CORPORATION COMMISSION OF KANSAS
OIL & GAS CONSERVATION DIVISION
WELL COMPLETION OR RECOMPLETION FORM
ACO-1 WELL HISTORY
DESCRIPTION OF WELL AND LEASE

API NO. 15- 193-20,489

County Thomas

130' W of the NE. NW. NE. Sec. 5 Twp. 10S Rge. 31W — East / — West

4950 Ft North from Southeast Corner of Section
1780 Ft West from Southeast Corner of Section
(Note: Locate well in section plat below)

Lease Name Albers "A" Well # 1

Field Name

Producing Formation

Elevation: Ground 3011 KB 3016

Operator: License # 5046
Name Raymond Oil Company Inc
Address P.O. Box 48788

City/State/Zip Wichita KS 67201

Purchaser

Operator Contact Person Patrick R. Raymond
Phone 316-267-4214

Contractor: License # 6033
Name Murfin Drilling Company

Wellsite Geologist Clarke Sandberg
Phone 316-267-4214

Designate Type of Completion
X New Well — Re-Entry — Workover

— Oil — SWD — Temp Abd
— Gas — Inj — Delayed Comp.
XXX Dry — Other (Core, Water Supply etc.)

If OWWO: old well info as follows:
Operator
Well Name
Comp. Date Old Total Depth

Section Plat

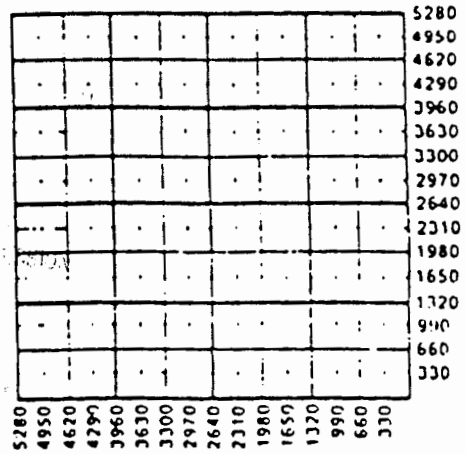

WELL HISTORY

Drilling Method:
X Mud Rotary — Air Rotary — Cable

11-14-89	11-22-89	11-23-89
Spud Date	Date Reached TD	Completion Date

4670	
Total Depth	PBTD

Amount of Surface Pipe Set and Cemented at 250 feet
Multiple Stage Cementing Collar Used? — Yes — No
If yes, show depth set feet
If alternate 2 completion, cement circulated from feet depth to w/ SX cmt
Cement Company Name
Invoice #

WATER SUPPLY INFORMATION
Disposition of Produced Water: — Disposal
Docket # — Repressuring

Questions on this portion of the ACO-1 call:
Water Resources Board (913) 296-3717
Source of Water: Pumped
Division of Water Resources Permit #

— Groundwater Ft North from Southeast Corner
(Well) Ft West from Southeast Corner of
Sec Twp Rge — East — West

— Surface Water Ft North from Southeast Corner
(Stream, pond etc) Ft West from Southeast Corner
Sec Twp Rge — East — West

— Other (explain)
(purchased from city, R.W.D. #)

DEC 18 1989
STATE GEOLOGICAL SURVEY
DEC 11 1989
KANSAS GEOLOGICAL SURVEY WICHITA BRANCH

INSTRUCTIONS: This form shall be completed in triplicate and filed with the Kansas Corporation Commission, 200 Colorado Derby Building, Wichita, Kansas 67202, within 120 days of the spud date of any well. Rule 82-3-130, 82-3-107 and 82-3-106 apply.
Information on side two of this form will be held confidential for a period of 12 months if requested in writing and submitted with the form. See rule 82-3-107 for confidentiality in excess of 12 months.
One copy of all wireline logs and drillers time log shall be attached with this form. Submit CP-4 form with all plugged wells. Submit CP-111 form with all temporarily abandoned wells.