

REVISED

STATE CORPORATION COMMISSION OF KANSAS  
OIL & GAS CONSERVATION DIVISION

WELL COMPLETION OR RECOMPLETION FORM  
ACO-1 WELL HISTORY

DESCRIPTION OF WELL AND LEASE

Operator: License # 8996  
Name Mid Continent Resources, Inc.  
Address 2805 Bentbay Circle  
City/State/Zip Wichita, KS 67204

Purchaser Koch Oil

Operator Contact Person Don V. Rider  
Phone (316) 838-9069

Contractor: License # 6033  
Name Murfin Drlg. Co.

Wellsite Geologist Don V. Rider  
Phone (316) 838-9069

Designate Type of Completion

- New Well  Re-Entry  Workover
- Oil  SWD  Temp Abd
- Gas  Inj  Delayed Comp.
- Dry  Other (Core, Water Supply etc.)

If OWWO: old well info as follows:

Operator  
Well Name  
Comp. Date Old Total Depth

WELL HISTORY

Drilling Method:

- Mud Rotary  Air Rotary  Cable

7/5/85 Spud Date 7/13/85 Date Reached TD 9/5/85 Completion Date  
4667' Total Depth PBSD

Amount of Surface Pipe Set and Cemented at 319 feet  
Multiple Stage Cementing Collar Used?  Yes  No  
If yes, show depth set 2540 feet  
If alternate 2 completion, cement circulated 1ite from 2540 feet depth to surface 550SX cmt

API NO. 15-175-20-865 193-20,358 Ind

County Thomas

NE NW SW Sec 31 Twp 10S Rge 31  East  West

2310 Ft North from Southeast Corner of Section  
4290 Ft West from Southeast Corner of Section  
(Note: Locate well in section plat below)


Lease Name Moorhous Well # 4-85

Field Name Campus North

Producing Formation Kansas City

Elevation: Ground 3029 KB 3034

Section Plat

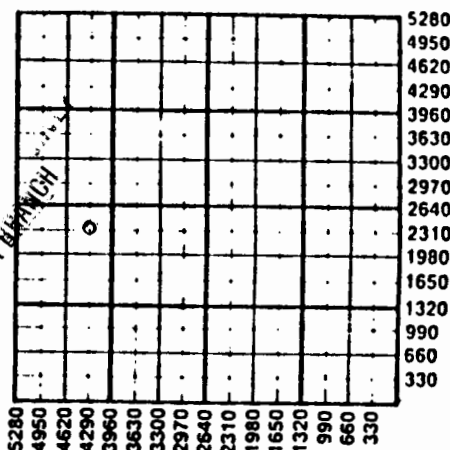

KANSAS BELLEVILLE WICHITA BRANCH

WATER SUPPLY INFORMATION

Disposition of Produced Water:  Disposal  Repressuring  
Docket #

Questions on this portion of the ACO-1 call:  
Water Resources Board (913) 296-3717

Source of Water:  
Division of Water Resources Permit #

Groundwater Ft North from Southeast Corner (Well) Ft West from Southeast Corner of Sec Twp Rge  East  West

Surface Water Ft North from Southeast Corner (Stream, pond etc) Ft West from Southeast Corner Sec Twp Rge  East  West

Other (explain) (purchased from city, R.W.D. #)

INSTRUCTIONS: This form shall be completed in duplicate and filed with the Kansas Corporation Commission, 200 Colorado Derby Building, Wichita, Kansas 67202, within 90 days after completion or recompletion of any well. Rule 82-3-130 and 82-3-107 apply.

Information on side two of this form will be held confidential for a period of 12 months if requested in writing and submitted with the form. See rule 82-3-107 for confidentiality in excess of 12 months. One copy of all wireline logs and drillers time log shall be attached with this form. Submit CP-4 form with all plugged wells. Submit CP-111 form with all temporarily abandoned wells.