


Section 32 Township 10 Range 15W

Well No. 1 Seefeld

Company B & R & Wilcox

Wildcat
NORTH

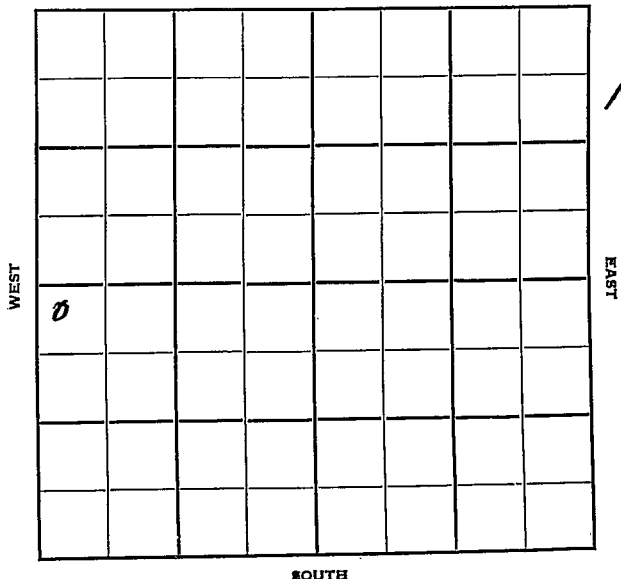

Osborne KANSAS

Sec. 32 Twp. 10 R. 15W ✓

Well No. #1 Seefeld Farm

B & R & Wilcox Company


(B & R, Cont.)

330' Ft. from N. Line

_____ Ft. from S. Line

_____ Ft. from E. Line

330' Ft. from W. Line

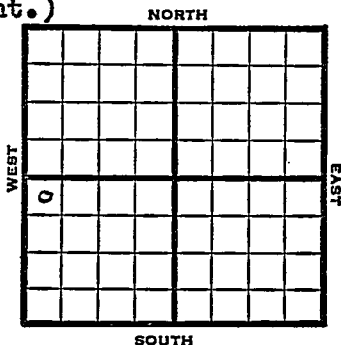

NW SW

1949

Elev. 2070' REPORT

6/22

8" @ 207'
Drlg. 2850'

6/28

Topeka 3034'
Lansing 3330'

7/6

ong 3683'
Drlg 3920'
Simp 3906'
Arb. 3923'
TD 3950'
ABANDONED

Kansas

Map No. _____ Sec. 32 Twp. 10 R. 15WWell No. 1 Seefeld

_____ B & R & Wilcox _____ Company

_____ B & R _____ Contractor

NW SW

FIRST SECTION REPORT

330 Ft. from N. Line

_____ Ft. from S. Line

_____ Ft. from E. Line

330 Ft. from W. Line

| | | | |
|---|--|--|--|
| | | | |
| | | | |
| o | | | |
| | | | |

Osborne County

Location _____

Rig up _____

Drilling and Remarks:

8" @ 207

drlr. 2850

RECORD

Cased _____ in., _____ ft.

Sand _____

Gas _____

Oil _____

Total Depth _____

PRODUCTION

1st 24 hrs. Nat. _____

1st 24 hrs. after shot _____

Gas _____ Cu. Ft.

Dry Hole _____

Abandoned _____

Date

JUN 22 1949

19

S. J. LEWIS Scout

Kansas

Wildcat

Map No. K63 Sec. 32 Twp. 10 R. 15W

Well No. 1 Seefeld

B & R & Wilcox Company

ABANDONED

Contractor

NW SW

E12070
SECTION PLAT

330 Ft. from N. Line

_____ Ft. from S. Line

_____ Ft. from E. Line

330 Ft. from W. Line

| | | | |
|---|--|--|--|
| | | | |
| | | | |
| Δ | | | |
| | | | |

Osborne County

Location _____

Rig up _____

Drilling and Remarks:

*Emp 3906
Ct 3923*

RECORD

Cased _____ in., _____ ft.

Sand _____

Gas _____

Oil _____

Total Depth 3952

PRODUCTION

1st 24 hrs. Nat. _____

1st 24 hrs. after shot _____

Gas _____ Cu. Ft.

Dry Hole _____

Abandoned _____

Date

JUL 6 1949 19

S. J. LEWIS Scout