


Section 32 Township 10 Range 17W

Well No. 1 Ridler "K"

Company Bay Petroleum

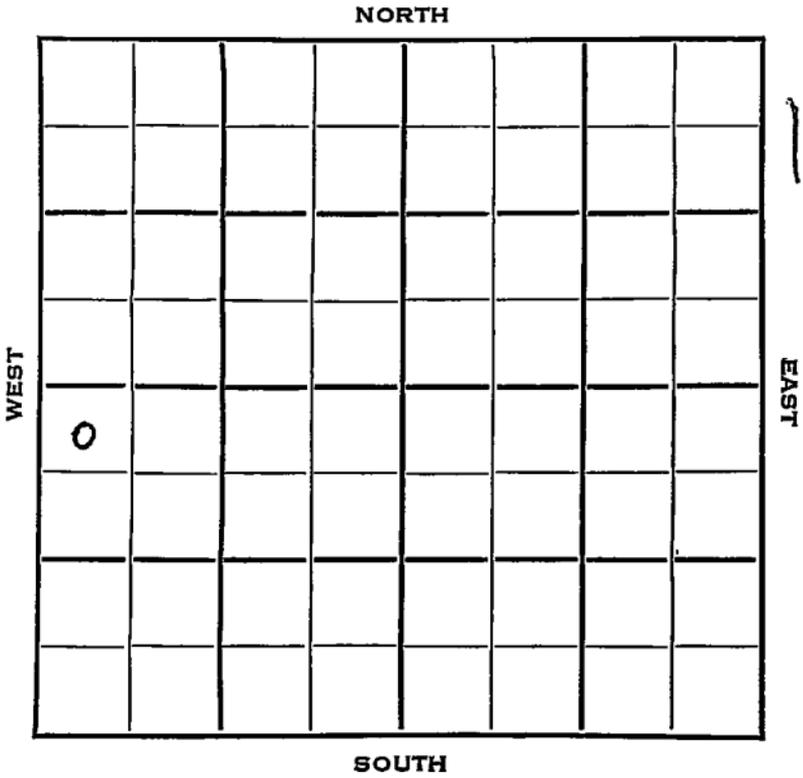

Rooks

KANSAS


SEC.	TWP.	R.
32	10	17 W ✓

WELL NO. # I Ridler "K" FARM

COMPANY Bay Petroleum

CONTRACTOR Lewis Drlg.

330 \_\_\_\_\_ Ft. from N. Line  
 \_\_\_\_\_ Ft. from S. Line  
 \_\_\_\_\_ Ft. from E. Line  
 330 \_\_\_\_\_ Ft. from W. Line

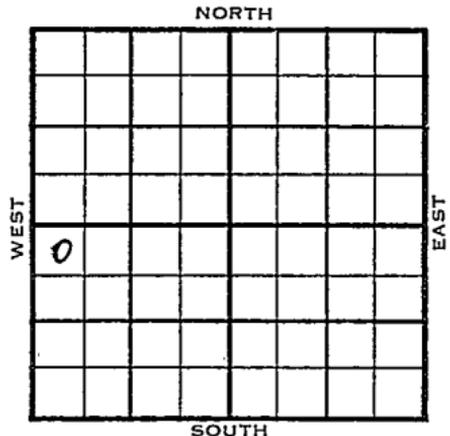

NW NW SW

1954	ELEVATION	REPORT
	2034'	
1/13	Spud 1-7-54 8" @ 193 Drlg. 2045'	
1/20	Drlg.	
3/3	Spud 1-7-54 Oil Well TD 3656' 8" @ 193' Heeb 3221', Tor 3237', Lans 3259' DST 3325-48', opn 1 hr., rec. 170' gas, 130' hocm, 1200# DST 3410-40', opn 1 hr., rec. 15' mud, 600# DST 3440-75', opn 1 hr., rec. 10' mud, 0# Cong 3511', Simp. 3581' DST 3582-89', opn 1 hr., rec. 25' mud, 1180# Arb. 3606' DST 3606-10', opn 1 hr., rec. 65' mud, 1040# DST 3609-15', opn 1 hr., rec. 35' mud, 1030# TD 3656' EX 5" @ 3478', 6/3426-28, 6/3424-26, 6/3428-30, SSO&W, 1000A, 1/2 bfph 50% wtr., SP 3410	

OVER

(Information Brought Forward)

1954  
3/3

12/3396-3400', 10 gwph 12/3360-64,  
42 gwph, SP 3350'

24/3340-46, 2 gw 4. go  $\frac{1}{4}$  hrs.

1000A

S/7 boph 3 hrs.

Comp. 99 bopd 1% wtr.

**COMPLETED**





Drlg. Data

24/ 3340-46

2 gw 4 go  $\frac{1}{2}$  hr. 1000 A

S/ 7 boph

3 hr.

Comp

99 bond

1/4 wtr.

_____	Misc.

Soot Cards  
Land Small Map  
Land Wall Map  
Tracts  
Trance Map  
Eriose Map

0.8

1954

MAR 8