

Sec. 32 Twp. 10 R. 17W

Well No. #1 Shaw Farm

Pabco Drlg. Company

Pabco Drlg. Contractor

Wildcat


 Ft. from N. Line

330 Ft. from S. Line

330 Ft. from E. Line

 Ft. from W. Line

SE SE SW

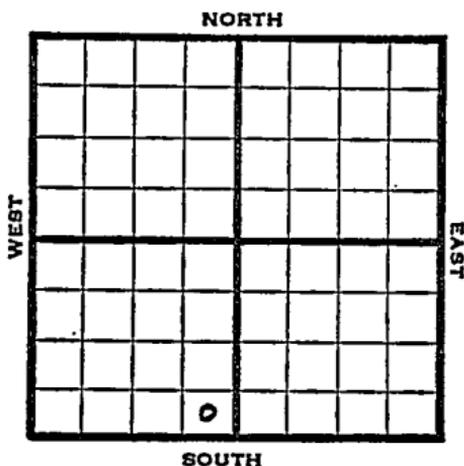

1953 Elev. 1921' REPORT

5/6 Spud 4-28-53
8" @ 204'
Heeb 3130, Lans 3172,
Drlg 3280'

5/13 Spud 4-28-53
D & A
TD 3555'
8" @ 204'
Heeb 3130, Lans 3172,
DST 3295-3319 opn 1/2 hr, rec 20' mud,
120# Cong 3457
DST 3458-70 opn 1/2 hr, rec 10' mud Off
Simp 3507, Arb 3539
TD 3555
D & A.

ABANDONED

