


SECTION 32 TOWNSHIP 10 RANGE 17W

WELL NO. #1 Keidler "K"

COMPANY Tenn. Gas Transmission

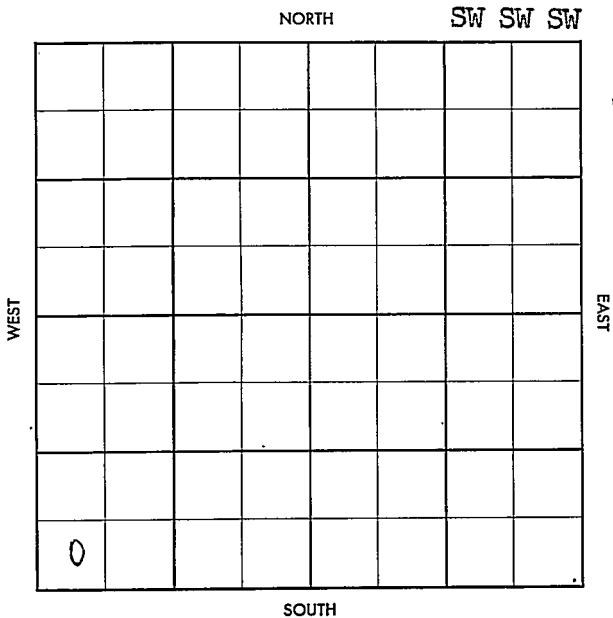

County Rooks Elev. 1939 DF

Sec. 32 Twp. 10 Rge. 17W

Company Tenn. Gas Transmission

Farm Name Keidler "K" No. 1

TOPS	DEPTH	LOG	DATUM
Anh.	1202		
Tp.			
H.			
Tr.			
Dg.			
Bl.			
L.			
K.C.			
B.K.C.			
Ce.			
C.			
M.			
M.			
K.			
Mz.			
Mo.			
V.			
S.			
S.			
A.			
R.			
Pe.			
G.			
T.D.			

Loc. in Sec.

SW SW SW

Geol.

Contr.

Shelley Mill

Pool

BURNETT

MAR 6 '57

FIRST REPORT

0

Date Comm. 2-27-57

8" @ 1211, Drlg. 2755

Co.

Loc.

No.

Sec.

T.

R.

Co.

No.

Sec.

T.

Co.

No.

Co.

County Rooks Elev. 1939 DF
 Sec. 32 Twp. 10 Rgs. 17W
 Company Tenn. Gas Transmission
 Farm Name Keidler "K" No. 1

TOPS	DEPTH	LOG	DATUM	Loc in Sec.
Anh.	1202			SW SW SW
Tr.				
H.	3131			
Tr.	3151			
Dg.				
Bl.				
L.	3173			
K.C.				Geol.
B.K.C.				Contr.
Ce.				<u>Shelley-Miller</u>
C.	3435			Pool
M.				<u>Burnett</u>
M.				
K.				
Mz.				
Ma.				
V.				
S.	3495			
S.				
A.	3512			ABANDONED
R.				
PE.				
G.				
TR.	3594			MAR 20 '57

Date Comm. 2-27-57

8" @ 1211, Drlg. 2755 MAR '3 '57 DST 3314-22
 (60) wk Blc rec 5' M FP 100
~~BHP~~ DST 3457-90 (30) rec 9' M
 SSO: BHP 705 (30) DST 3512-14 (30)
 rec 70' M BHP 985 (30)
 DST 3514-23 rec 29' M BHP 1100 (30)
 DST 3523-32 MAR 20 '57 op 90" net 1.54
 MSW BHP 1258/304
 D&A