


Rooks .

Section 32 Township 10 Range 18W

Well No. #1 Gardner

Company B & B Drlg.

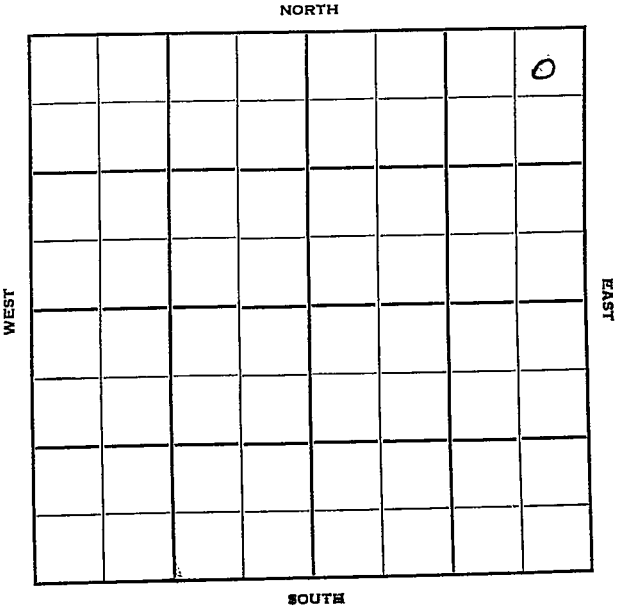


Rooks KANSAS

Sec. 32 Twp. 10 R. 18 WWell No. # 1 Gardner FarmB & B Drlg. CompanyB & B Drlg. ContractorWildcat330 Ft. from N. Line

Ft. from S. Line

330 Ft. from E. Line

Ft. from W. Line

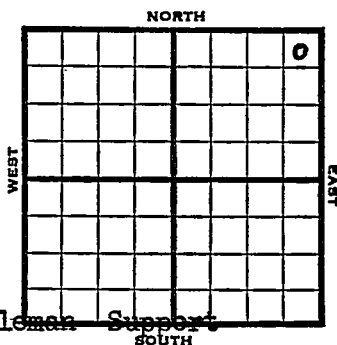

NE NE NE

Mid-States & Nate Appleman Support

1953 Elev. 2070' REPORT

3/18 Spud 3-16-53
8" @ 1503/26 Anhy 1430, Top 3083, Heeb 3307
Tor 3325-39, Lans 3349
Drlg. 3365'4/1 Spud 3-16-53
D & A
TD 3760
8" @ 150
Anhy 1430, Top 3083, Heeb 3307, Tor
3325, Lans 3349, Cong 3622, Simp
3721, Arb 3747
TD 3760
D & A**ABANDONED**

County Rooks State Kansas
 Sec. 32 (Blk. Twp.) 10 (Sur. Rge.) 18W Map No. _____
 Operator B & B Drlg.
 Well No. 1 Farm Gardner
 Elev. _____ Location NE NE NE

						0

330 Ft. From N Line NE

330 Ft. From E Line Quarter

1st. Report MAR 1 8 1953

Completion _____

Remarks Mid-States & Nate
Appleman - support

B & B Drlg. - Contr.

Spudding Date 3-16-53

Drlg. Data _____

Wildcat

8" @.150

J. E. McGEHEE

J. G. McCRACKEN