

Section 32 Township 10 Range 20W
Well No. #1 A. M. McKenna
Company I.O. Miller et al

NORTH

				0			

WEST

EAST

SOUTH

Rooks

KANSAS

SEC.	TWP.	R.
32	10	20 W

WELL NO.

1 A. M. McKenna

FARM

COMPANY

I. O. Miller et al

CONTRACTOR

Virginia Drlg.

Allphin Pool


330 Ft. from N. Line

Ft. from S. Line

Ft. from E. Line

330 Ft. from W. Line

NW NW SE

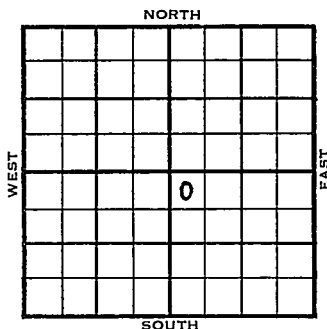

1955

ELEVATION

2166'

REPORT

1/19

Spud 1-17-55
8" @ 225' WOC

2/9

Spud 1-17-55
D & A

TD 3790'

8" @ 225'

Heeb 3411', Tor. 3432' Lans 3447'


Cong. 3708'

TD 3790'

D & A

ABANDONED

FABEN GU STRAD

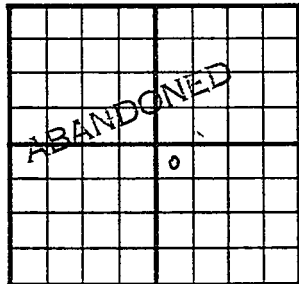County _____ Rocks _____ State KansasSec. 32 (Blk. 10) (Sur. 20W) (Twp. Map No.)Operator I. O. Miller et al.Well No. 1 Farm A. M. McKennaElev. 2166 Location NW NW SE330 Ft. From N Line SE330 Ft. From W Line QuarterIst. ReportCompletion FEB 9 1955Remarks Allphin PoolVirginia Drlg. - Contr.Spudding Date 1-17-55Drlg. Data D & A TD 37908" @225 Heeb. 3411 Tor. 3432Lans. 3447 Cong. 3708 TD 3790D & A

FABEN GILSTRAP