

Rooks KANSAS


DX 78-1

Section 32 Township 10 Range 20W

Well No. 2 Waite

Company Heathman & Seeligson

NORTH

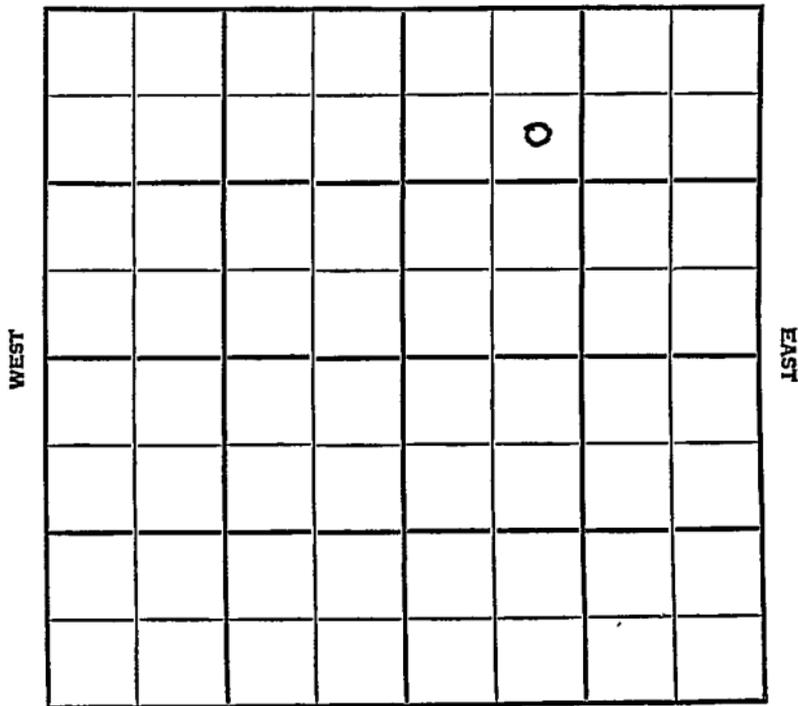

SOUTH

WEST

EAST

Rocks KANSAS

SEC.	TWP.	R.
32	10	20W ✓

WELL NO. **2 Waite** FARM

COMPANY **Heathman & Seeligson**

CONTRACTOR **Co. tools**


Laura Pool

990 Ft. from N. Line

Ft. from S. Line

Ft. from E. Line

990 Ft. from W. Line

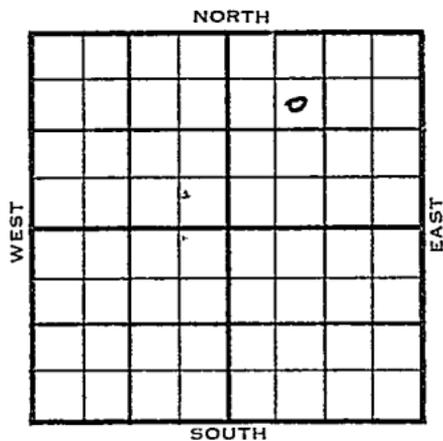

SE NW NE

	ELEVATION	REPORT
1954	2197	
6/123		Spdg. 6-16-54 8" @ 163 Anhy 1663
6/30		Drlg. 3065 Heeb 3427', Tor 3447', Lans 3465' DST 3470-3511', 1 hr., 70' O&GCM, 60' hly O&GCM, 60' MCO, 1170# DST 3547-54', 1 hr., 15' OCM, 180' oil 1170# DST 3555-72', 1 hr., 60' MCW, 1185# DST 3644-71', 1 hr., 50' M, 0# Arb. 3751' RTD 3761' 5" @ 3760'
7/7		CO 3761' SSO DD 3763' FU 375' oil, 1½ hrs., S/6 BOPH 5 hrs., 500A FU 1700' oil 1½ hrs. S/33 boph 3 hrs.
7/21		Spdg 6-16-54 Oil well TD 3763 8 " @ 163 Anhy 1663 Heeb. 3427 Tor. 3447 Lans. - 3465 DST 3470-3511

1954
7/21

Information brought forward

open 1 hr. Rec. 70' o & gcm 60' ho &
gcm 60' mco 1170#
DST 3547-54 open 1 hr. Rec. 15' hocm
180' oil 1170#
DST 3555-72 open 1 hr. Rec. 60' mcw
1185#
DST 3644-71 open 1 hr. Rec. 50' mud O#
Arb 3751
TD 3761
5" @ 376L CO to 3761 SSO DD 3763
FU 375' oil 1 1/2 hr. S/6 boph 5 hr.
500 A FU 1700' oil 1 1/2 hr. S/ 33 boph
3 hr.
Comp. 484 bopd

COMPLETED

