


Section 32 Township 10 Range 20W

Well No. #5 Wait

Company Heathman-Seeligson

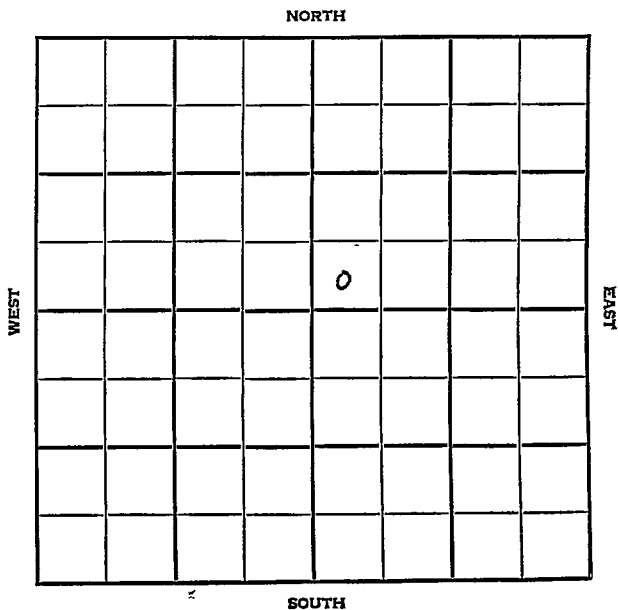

Rooks

KANSAS

SEC.	TWP.	R.
32	10	20W

WELL NO.

#5 Wait

FARM

COMPANY

Heathman-Seeligson

CONTRACTOR

Co. Tools.


_____ Ft. from N. Line

330 _____ Ft. from S. Line

_____ Ft. from E. Line

330 _____ Ft. from W. Line

SW SW NE

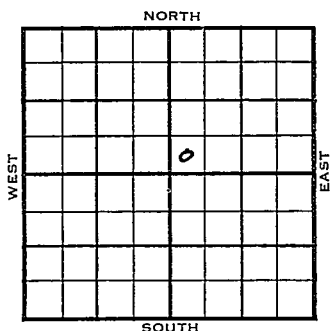

1954

ELEVATION
2177'

REPORT

11/23

M I R

1955

1/12

Spud 11-23-54

Oil Well

TD 3753'

8" @ 155'

Anhy 1635' Heeb 3414' Lans 3450'

DST 3442'-96' opn 1 hr rec 630' s.w.
1120#DST 3507'-39' opn 1 hr, rec 185' wtr.
120' wtr & oil 920#DST 3564'-3620' opn 1 hr rec 180' gas,
60' socm 60' hocm, 60' vhocm 90' oil
1010#DST 3622'-60' opn 1 hr, rec 15' Mud O#
B KC 3671' Cong 3704' Simp 3720' Arb.
3739'

TD 3742'

5" @ 3741'

DD 3753' S/ 1 1/2 boph 1000 A S/ 10
boph 3 hr.

Comp 265 bopd.

COMPLETED

County _____ Rooks State Kansas
 Sec. 32 (Blk. Twp.) 10 (Sur. Rge.) 20W Map No. _____
 Operator Heathman-Seeligson
 Well No. 5 Farm Wait
 Elev. 2177 Location SW SW NE

330 Ft. From S Line NE
330 Ft. From W Line Quarter
 Ist. Report _____
 Completion JAN 1 2 1955
 Remarks _____
Co. tools
 Spudding Date 11-23-54

Drlg. Data Oil well TD 3753
8" @ 155 Anhy 1635 Heeb. 3414
Lans. 3450 DST 3442-96 open 1 hr.
Rec. 630' sw 1120# DST 3507-39
open 1 hr. Rec. 185' wtr. 120' wtr & oil
920# DST 3564-3620 open 1 hr. Rec.
180' gas -60' socm 60' hocm 60' vhocm
90' oil 1010# DST 3622-60 open 1 hr.
Rec. 15' mud 0# B KC 3671 Cong. 3704
Simp. 3720 Arb. 3739 TD 3742
5" @ 3741 DD 3753 S/ 1 1/2 boph 1000 A
S/ 10 boph 3 hr. Comp. 265 bopd

FABEN GILSTRAP