

Section 32 Township 10 Range 21WWell No. #1 Noah "F"Company Jones, Shelburne & Farmer

NORTH

|  |  |  |  |  |  |  |   |
|--|--|--|--|--|--|--|---|
|  |  |  |  |  |  |  |   |
|  |  |  |  |  |  |  |   |
|  |  |  |  |  |  |  |   |
|  |  |  |  |  |  |  |   |
|  |  |  |  |  |  |  | 5 |
|  |  |  |  |  |  |  |   |
|  |  |  |  |  |  |  |   |
|  |  |  |  |  |  |  |   |

WEST

EAST

SOUTH

Graham KANSAS



Sec. 32 Twp. 10 R. 21 W

Well No. # 1 Noah "F" Farm

Jones, Shelburne & Farmer Company

J-S-F Contractor

Wildcat


330 Ft. from N. Line

Ft. from S. Line

330 Ft. from E. Line

Ft. from W. Line

NE NE SE  
Cont'l acreage

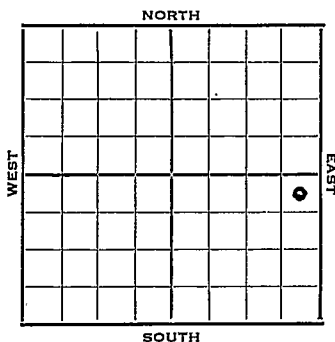


1952 Elev. 2204' REPORT

9/4 Spud 8-31-52  
8" @ 165 Anhy 1700'  
Drlg. 2265'  
9/10 Heeb 3485' Tor. 3507' Lans 3525'  
Drlg. 3681'  
9/17 Spud. 8-31-52  
D&A TD 3890'  
8" @ 165'  
Anhy 1700 Heeb. 3485  
Tor. 3507 Lans. 3525  
B KC 3760 Arb. 3859  
DST 3818-70, open 1 hr. rec.  
420' SW 1360# TD 3890' D&A

**ABANDONED**

J. G. McGEHEE

County Graham State Kansas  
 Sec. 32 (Blk.) 10 (Sur.) 21W Map No.  
 Operator Jones, Shelburne & Farmer  
 Well No. 1 Farm Noah "F"  
 Elev. 2204 Location NE NE SE

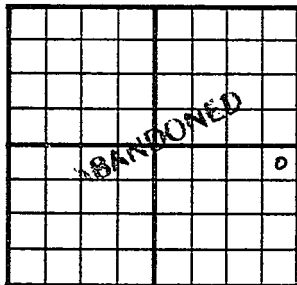

330 Ft. From N Line SE  
330 Ft. From E Line Quarter  
1st. Report  
Completion SEP 17 1952  
Remarks Wildcat  
J-S-F - Contr.  
Spudding Date 8-31-52

Drig. Data D & A TD 3890

8" @ 165 Anhy 1700 Heeb. 3485

Tor. 3507 Lans. 3525 B KC 3760

Arb. 3859 DST 3818-70 open 1 hr.

Rec. 420' sw 1360# TD 3890

D & A

J. G. McGEHEE