

Graham

KANSAS

SECTION 32 TOWNSHIP 10 RANGE 22 W

WELL NO. #1 Lacerte

COMPANY Petroleum Inc. & Colo. O & G

NORTH

WEST								EAST

SOUTH

Graham

KANSAS

SEC.	TWP.	R.
32	10	22W

WELL NO.

#1 Lacerte

FARM

COMPANY

Petroleum Inc. & Colo. O & G.

CONTRACTOR

Garvey


_____ Ft. from N. Line

_____ Ft. from S. Line

_____ Ft. from E. Line

_____ Ft. from W. Line

NW NE SW

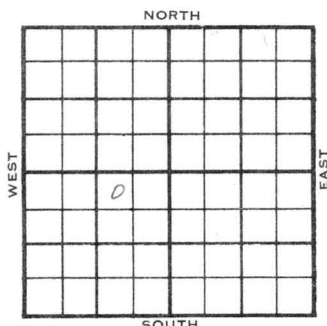

	ELEVATION	REPORT
1956	2282 RB	
1-18	Comm. 1-11-56 8" @ 208/135 DST 3564-90 op $\frac{1}{2}$ hr. rec. 15' mud, 1020/20" DST 3589-3630 op 1 hr. rec. 120' ho&gc 300' muddy oil, 240' clean oil, 1120/20" Anh. 1781 Tp. 3300 H. 3523 Tr. 3540 L. 3562	
3-21	DST 3650-3725 op 1 hr. rec. 45' mud, 135# DST 3725-95 op 40 min, rec 15' mud, 150/20" 4 $\frac{1}{2}$ " @ 3730 CO to 3637 16/ 3622-26, 16/ 3602-06, 3 boph, 3 hrs 3500 A, 18 boph, 25% wtr. 6 hrs. P/ 80 bo 28% wtr. Comp. 61 bopd, 25% wtr. # A. 3988 TD 4013	

COMPLETED

County Graham Elev. 2282 RBSec. 32 Twp. 10 Rge. 22WCompany Petroleum Inc. & Colo. O & GFarm Name Lacerte No. 1

TOPS	DEPTH	LOG	DATUM	Loc. in Sec.
Anh.	1781			NW NE SW
Tr.	3300			
H.	3523			
Tr.	3540			
Dg.				
Bl.				
L.	3562			
K.C.				Geol.
B.K.C.				Contr.
Ce.				Garvey
C.				
M.				
M.				Pool
K.				
Mz.				
Mq.				
V.				
S.				
S.				
A.				
R.				
Pf.				
G.				
T.D.				

FIRST REPORT

0

JAN 13 '56

Date Comm. 1-11-568" @ 208/135 DST 3564-90 open $\frac{1}{2}$ hr.

rec. 15' mud 1020/20" DST 3589-3630

open 1 hr. rec. 120' ho & gem

300' muddy oil 240' clean oil 1120/20"

2280 DF

2282 RB

County

Graham

Elev.

Sec.

32

Twp.

10

Rge.

22W

Company

Petroleum Inc. & Colo. O & G

Farm Name

Lacerte

No.

1

TOPS	DEPTH	LOG	DATUM	Loc. in Sec.
Anh.	1781			NW NE SW
T.P.	3300			
H.	3523			
Tr.	3540			
Dg.				
BL.				
L.	3562		1282	Geol.
K.C.				Contr.
B.K.C.				Garvey
Ce.				Pool
C.				
M.				
M.				
K.				
Mz.				
Mo.				
V.				
S.				
S.				
A	3988		1700	COMPLETE
R.				
PE.				
G.				
T.D.	4013			

Date Comm.

1-11-56

MAR 21 1956

8" @ 208/135 DST 3564-90 open $\frac{1}{2}$ hr.

rec. 15' mud 1020/20" DST 3589-3630

open 1 hr. rec. 120' ho & gcm

300' muddy oil 240' clean oil 1120/20"

DST 3650-3725 open 1 hr. rec. 45' mud

135# DST 3725-95 open 40 min.

rec. 15' mud 150/20" $4\frac{1}{2}$ " @ 3730

CO to 3637 16/ 3622-26 16/ 3602-06

OVER

3 boph 3 hr. 3500 A 18 boph

25% wtr. 6 hr. P/ 80 bo 28% wtr.

Comp. 61 bopd 25% wtr.

R.G.

APR 2 1956