

3512
COPY
SIDE ONE

CONFIDENTIAL

STATE CORPORATION COMMISSION OF KANSAS
OIL & GAS CONSERVATION DIVISION
WELL COMPLETION FORM
ACO-1 WELL HISTORY
DESCRIPTION OF WELL AND LEASE

Operator: License # 5363

Name: BEREXCO INC.

Address 970 Fourth Financial Center

City/State/Zip Wichita, Kansas 67202

Purchaser: Central Crude Corporation

Operator Contact Person: Leon Rodak

Phone (316) 265-3311

Contractor: Name: Murfin Drilling Co.

License: 6033

Wellsite Geologist: None

Designate Type of Completion

 New Well Re-Entry X Workover

X Oil SWD Temp.

 Gas Inj Delayed Completion

 Dry Other (Core, Water Supply, etc.)

If OWM: old well info as follows:

Operator: Donald C. Slawson & American

Well Name: #1 Spiers "D"

Comp. Date 3/14/82 Old Total Depth 4760

Drilling Method:

X Mud Rotary Air Rotary Cable

11/18/90 11/19/90 2/11/91

Spud Date Date Reached TD Completion Date

API NO. 15- 193-20,239-3-0001

County Thomas

C NW NW Sec. 29 Twp. 10S Rge. 32 X East West

4630 Ft. North from Southeast Corner of Section

4580 Ft. West from Southeast Corner of Section

(NOTE: Locate well in section plat below.)


Lease Name Spiers Well # 2

Field Name Riverford

Producing Formation Ft. Scott, Altamont, LKC

Elevation: Ground 3080 KB 3085

Total Depth 4760 PBD 4698

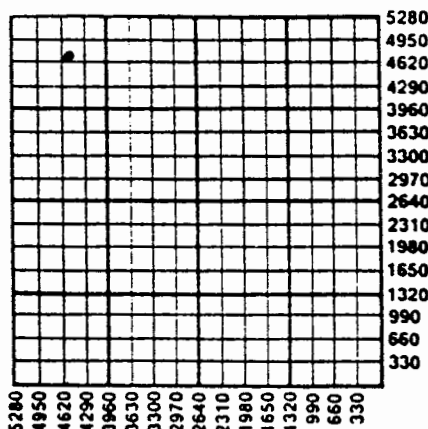

Amount of Surface Pipe Set and Cemented at 338 Feet

Multiple Stage Cementing Collar Used? X Yes No

If yes, show depth set 2584 Feet

If Alternate II completion, cement circulated from 2584

feet depth to 750 w/ 600 sx cmt.

INSTRUCTIONS: This form shall be completed in triplicate and filed with the Kansas Corporation Commission, 200 Colorado Derby Building, Wichita, Kansas 67202, within 120 days of the spud date of any well. Rule 82-3-130, 82-3-107 and 82-3-106 apply. Information on side two of this form will be held confidential for a period of 12 months if requested in writing and submitted with the form. See rule 82-3-107 for confidentiality in excess of 12 months. One copy of all wireline logs and drillers time log shall be attached with this form. ALL CEMENTING TICKETS MUST BE ATTACHED. Submit CP-4 form with all plugged wells. Submit CP-111 form with all temporarily abandoned well's. Any recompletion, workover or conversion of a well requires filing of ACO-2 within 120 days from commencement date of such work.

All requirements of the statutes, rules and regulations promulgated to regulate the oil and gas industry have been fully complied with and the statements herein are complete and correct to the best of my knowledge.

Signature [Signature]

Title Executive Vice President Date 3/15/91

Subscribed and sworn to before me this 15th day of March, 19 91.

Notary Public [Signature]

Date Commission Expires October 31, 1994

K.C.C. OFFICE USE ONLY
F Letter of Confidentiality Attached
C Wireline Log Received
C Drillers Timelog Received

Distribution
 KCC SWD/Rep NGPA
 KGS Plug Other (Specify)

JOHANNA S. DOBLER
Notary Public - State of Kansas
My Appt. Expires 10/31/94

Form ACO-1 (7-89)