

STATE CORPORATION COMMISSION OF KANSAS
OIL & GAS CONSERVATION DIVISION

WELL COMPLETION OR RECOMPLETION FORM
ACO-1 WELL HISTORY

DESCRIPTION OF WELL AND LEASE

Operator: License # 5181
Name DONALD C. SLAWSON
Address 200 Douglas Building
City/State/Zip Wichita, Kansas 67202

Purchaser

Operator Contact Person Bill Horigan
Phone (316) 263-3201

Contractor: License # 5657
Name SLAWSON DRILLING CO., INC.

Wellsite Geologist Jim Gribi
Phone (316) 267-6248

Designate Type of Completion

New Well Re-Entry Workover

Oil SWD Temp Abd
 Gas Inj Delayed Comp.
 Dry Other (Core, Water Supply etc.)

If OWO: old well info as follows:

Operator
Well Name
Comp. Date Old Total Depth

WELL HISTORY

Drilling Method:

Mud Rotary Air Rotary Cable

11/18/85 11/27/85 11-27-85
Spud Date Date Reached TD Completion Date
4728' PBTD
Total Depth

Amount of Surface Pipe Set and Cemented at 345 feet
Multiple Stage Cementing Collar Used? Yes No
If yes, show depth set.....feet
If alternate 2 completion, cement circulated
from.....feet depth to.....w/.....SX cmt

API No. 15-193-20,379

County Thomas

SE NE SW Sec. 30 Twp. 10 Rge. 32 East West

1740 Ft North from Southeast Corner of Section
2980 Ft West from Southeast Corner of Section
(Note: Locate well in section plat below)


Lease Name Karlin GG Well # 1

Field Name Wildcat

Producing Formation

Elevation: Ground 3072 KB 3078

Section Plat

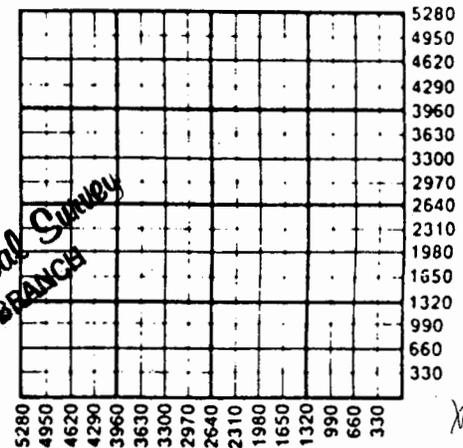

WATER SUPPLY INFORMATION

Disposition of Produced Water: Disposal Repressuring
Docket #

Questions on this portion of the ACO-1 call:

Water Resources Board (913) 296-3717

Source of Water:

Division of Water Resources Permit #

Groundwater.....Ft North from Southeast Corner
(Well)Ft West from Southeast Corner of
Sec Twp Rge East West

Surface Water.....Ft North from Southeast Corner
(Stream, pond etc).....Ft West from Southeast Corner
Sec Twp Rge East West

Other (explain).....
(purchased from city, R.W.D. #)

INSTRUCTIONS: This form shall be completed in duplicate and filed with the Kansas Corporation Commission, 200 Colorado Derby Building, Wichita, Kansas 67202, within 90 days after completion or recompletion of any well. Rule 82-3-130 and 82-3-107 apply.

Information on side two of this form will be held confidential for a period of 12 months if requested in writing and submitted with the form. See rule 82-3-107 for confidentiality in excess of 12 months. One copy of all wireline logs and drillers time log shall be attached with this form. Submit CP-4 form with all plugged wells. Submit CP-111 form with all temporarily abandoned wells.