SIDE ONE

S

STATE CORPORATION COMMISSION OF KANSAS
OIL & GAS CONSERVATION DIVISION
WELL COMPLETION OR RECOMPLETION FORM
ACO-1 WELL HISTORY
DESCRIPTION OF WELL AND LEASE

API NO. 15- 193-20,443

County Thomas

NW SE SW Sec. 36 Twp. 10 Rge. 32 ___ East X West

990 Ft North from Southeast Corner of Section
3630 Ft West from Southeast Corner of Section
(Note: Locate well in section plat below)

Lease Name Double "S" Well # 1

Field Name WC

Producing Formation

Elevation: Ground 3035' KB 3040'

Operator: License # 4629
Name Brito Oil Company
Address 200 E. First, #413
City/State/Zip Wichita, KS 67202

Purchaser None

Operator Contact Person Raul Brito
Phone 316-263-8787

Contractor: License # 5422
Name Abercrombie Drilling, Inc.

Wellsite Geologist Raul F. Brito
Phone 316-263-8787

Designate **Type of Completion**
___ New Well ___ Re-Entry ___ Workover

___ Oil ___ SWD ___ Temp Abd
___ Gas ___ Inj ___ Delayed Comp.
X Dry ___ Other (Core, Water Supply etc.)

If **OWWO:** old well info as follows:
Operator
Well Name
Comp. Date Old Total Depth

Section Plat

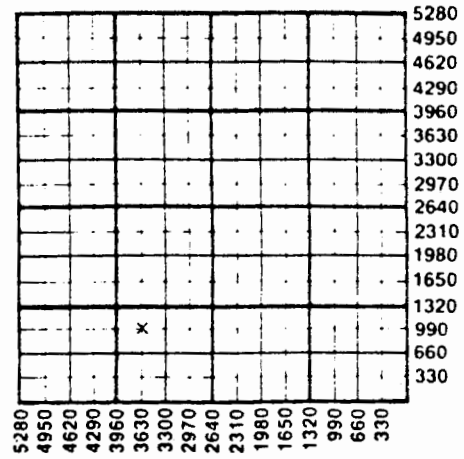

WATER SUPPLY INFORMATION

Disposition of Produced Water: ___ **Disposal**
Docket # ___ **Repressuring**

Questions on this portion of the ACO-1 call:
Water Resources Board (913) 296-3717

Source of Water:
Division of Water Resources Permit #

___ Groundwater Ft North from Southeast Corner
(Well) Ft West from Southeast Corner of
Sec Twp Rge ___ East ___ West

___ Surface Water Ft North from Southeast Corner
(Stream, pond etc) Ft West from Southeast Corner
Sec Twp Rge ___ East ___ West

X Other (explain) City of Oakley, KS
(purchased from city, R.W.D. #)

WELL HISTORY

Drilling Method:
X Mud Rotary ___ Air Rotary ___ Cable

8-12-87	8-16-87	8-17-87
Spud Date	Date Reached TD	Completion Date

4070'	
Total Depth	PBTD

Amount of Surface Pipe Set and Cemented at 330 feet
Multiple Stage Cementing Collar Used? ___ Yes X No
If yes, show depth set feet
If alternate 2 completion, cement circulated
from feet depth to w/ SX cmt
Cement Company Name
Invoice #

INSTRUCTIONS: This form shall be completed in triplicate and filed with the Kansas Corporation Commission, 200 Colorado Derby Building, Wichita, Kansas 67202, within 120 days of the spud date of any well. Rule 82-3-130, 82-3-107 and 82-3-106 apply.
Information on side two of this form will be held confidential for a period of 12 months if requested in writing and submitted with the form. See rule 82-3-107 for confidentiality in excess of 12 months.
One copy of all wireline logs and drillers time log shall be attached with this form. Submit CP-4 form with all plugged wells. Submit CP-111 form with all temporarily abandoned wells.

SIDE TWO

Operator Name Brito Oil Company Lease Name Double "S" Well # 1

Sec. 36 Twp. 10S Rge. 32 [ ] East [X] West County Thomas

WELL LOG

INSTRUCTIONS: Show important tops and base of formations penetrated. Detail all cores. Report all drill stem tests giving interval tested, time tool open and closed, flowing and shut-in pressures, whether shut-in pressure reached static level, hydrostatic pressures, bottom hole temperature, fluid recovery, and flow rates if gas to surface during test. Attach extra sheet if more space is needed. Attach copy of log.

Drill Stem Tests Taken [ ] Yes [X] No
Samples Sent to Geological Survey [X] Yes [ ] No
Cores Taken [ ] Yes [X] No

Formation Description
[ ] Log [X] Sample

Name	Top	Bottom
Anhydrite	2576	2604
Hebneer	4013	
Lansing	4055	
RTD	4070	

No Log.

CASING RECORD [ ] New [ ] Used
Report all strings set-conductor, surface, intermediate, production, etc.

Purpose of String	Size Hole Drilled	Size Casing Set (in O.D.)	Weight Lbs/Ft.	Setting Depth	Type of Cement	#Sacks Used	Type and Percent Additives
Surface	12-1/4	8-5/8	20	330	60/40 posmix	210	2% gel, 3% ca.cl.

PERFORATION RECORD

Shots Per Foot	Specify Footage of Each Interval Perforated

Acid, Fracture, Shot, Cement Squeeze Record

(Amount and Kind of Material Used)	Depth

TUBING RECORD Size Set At Packer at

Liner Run [ ] Yes [ ] No

Date of First Production

Producing Method
[ ] Flowing [ ] Pumping [ ] Gas Lift [ ] Other (explain)