Ind

S SIDE ONE

CONFIDENTIAL

STATE CORPORATION COMMISSION OF KANSAS
OIL & GAS CONSERVATION DIVISION

WELL COMPLETION OR RECOMPLETION FORM
ACO-1 WELL HISTORY

DESCRIPTION OF WELL AND LEASE

Operator: License # 5063
Name Energy Exploration, Inc.
Address 1002 South Broadway
City/State/Zip Wichita, KS 67211

Purchaser Koch Oil Co.

Operator Contact Person Brad Lehl
Phone 316-267-7336

Contractor: License # 5422
Name Abercrombie Drilling, Inc.

Wellsite Geologist Ralph White
Phone 263-3081

Designate Type of Completion
[X] New Well [ ] Re-Entry [ ] Workover

[X] Oil [ ] SWD [ ] Temp Abd
[ ] Gas [ ] Inj [ ] Delayed Comp.
[ ] Dry [ ] Other (Core, Water Supply etc.)

If OWWO: old well info as follows:
Operator N/A
Well Name
Comp. Date Old Total Depth

WELL HISTORY

Drilling Method:
[X] Mud Rotary [ ] Air Rotary [ ] Cable

1-13-86	1-23-86	1-23-86
Spud Date	Date Reached TD	Completion Date

4700'	4530'
Total Depth	PBTD

Amount of Surface Pipe Set and Cemented at 305 feet
Multiple Stage Cementing Collar Used? [X] Yes [ ] No
If yes, show depth set 2491 feet
If alternate 2 completion, cement circulated from 2491 feet depth to surface w/ 450 SX cmt

API NO. 15- 193-20,389

County Thomas

NW SE SE Sec. 36 Twp. 10S Rge. 32 [ ] East [X] West

990 Ft North from Southeast Corner of Section
990 Ft West from Southeast Corner of Section
(Note: Locate well in section plat below)

Lease Name Nichols Well # 3

Field Name Campus Northwest

Producing Formation Marmaton

Elevation: Ground 3032' KB 3037'

Section Plat

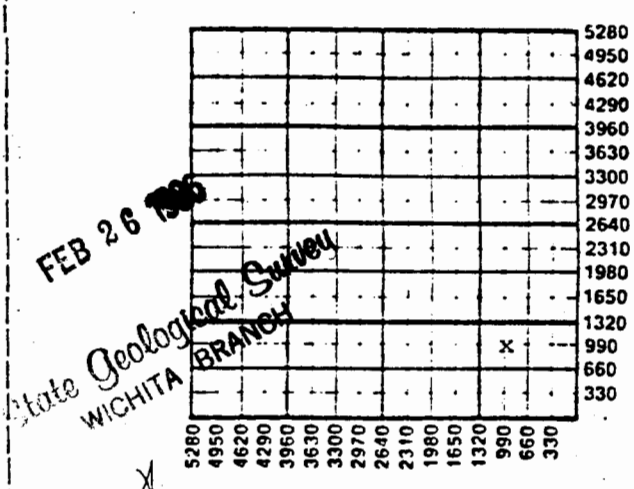

FEB 26 1986
State Geological Survey
WICHITA BRANCH

WATER SUPPLY INFORMATION

Disposition of Produced Water: [ ] Disposal
Docket # [ ] Repressuring

Questions on this portion of the ACO-1 call:
Water Resources Board (913) 296-3717

Source of Water:
Division of Water Resources Permit #

[ ] Groundwater Ft North from Southeast Corner
(Well) Ft West from Southeast Corner of
Sec Twp Rge [ ] East [ ] West

[ ] Surface Water Ft North from Southeast Corner
(Stream, pond etc) Ft West from Southeast Corner
Sec Twp Rge [ ] East [ ] West

[X] Other (explain) City of Oakley, KS
(purchased from city, R.W.D. #)

INSTRUCTIONS: This form shall be completed in duplicate and filed with the Kansas Corporation Commission, 200 Colorado Derby Building, Wichita, Kansas 67202, within 90 days after completion or recompletion of any well. Rule 82-3-130 and 82-3-107 apply.
Information on side two of this form will be held confidential for a period of 12 months if requested in writing and submitted with the form. See rule 82-3-107 for confidentiality in excess of 12 months.
One copy of all wireline logs and drillers time log shall be attached with this form. Submit CP-4 form with all plugged wells. Submit CP-111 form with all temporarily abandoned wells.