


Section 33 Township 10 Range 23 W

Well No. #7 Dieholt

Company Imperial Drlg.

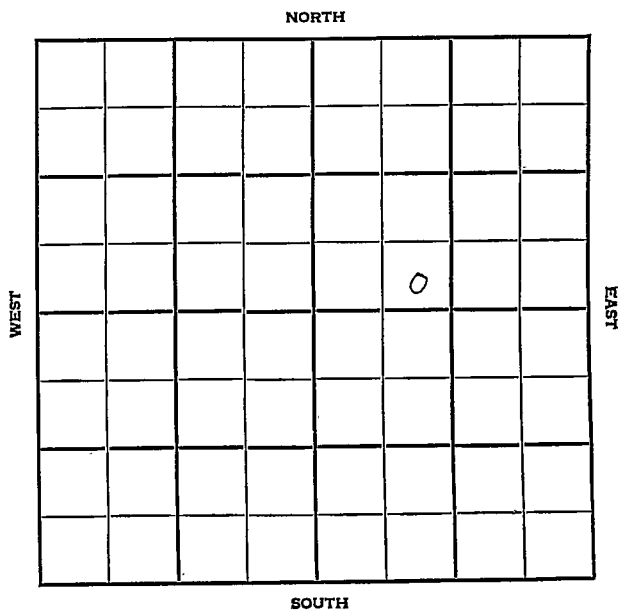

Graham

KANSAS

SEC.	TWP.	R.
33	10	23W

WELL NO.

#7 Disbolt

FARM

COMPANY

Imperial Drlg.

CONTRACTOR

Schafer


Diebolt

\_\_\_\_\_ Ft. from N. Line

\_\_\_\_\_ Ft. from S. Line

\_\_\_\_\_ Ft. from E. Line

\_\_\_\_\_ Ft. from W. Line

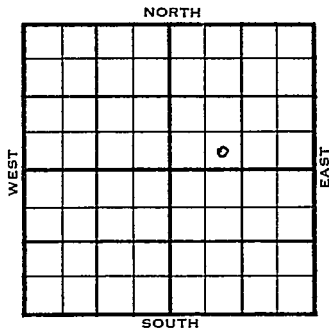

SE SW NE

1955	ELEVATION	REPORT
	2348'	
7/27	Location	
9-21	Comm. 7-27-55 8" @ 215 w/125; DST 3609-18 op 30" rec. 10' mud BHP 0# 20"; DST 3609-21 op 2 hrs. 20" rec. 166' gip, rec. 63' ocm, 60' ocw, BHP 720# 20"; 5½" @ 3780; fill 100' oil no wtr. 30"; swb 1.68 boph no wtr.; 3000 A; swb 21 boph no wtr. 3 hrs. 500' OB 24/3748-52; packer 3767; 3000 A; swb 28 boph no wtr.; swb average 6.5 boph no wtr.; Phy. pmp 209 bopd 10% wtr. Tops: Anh. 1850 H. 3547 Tr. 3566 L. 3583	
	T.D. 3780'	COMPLETED

County Graham Elev. \_\_\_\_\_  
 Sec. 33 Twp. 10 Rge. 23W  
 Company Imperial Drig.  
 Farm Name Diebolt No. 7

TOPS	DEPTH	LOG	DATUM
Anh.			
Tp.			
H.			
Tr.			
Dg.			
Bl.			
L.			
K.C.			
B.K.C.			
Ce.			
C.			
M.			
M.			
K.			
Mz.			
Mq.			
V.			
S.			
S.			
A			
R.			
PE.			
G.			
TD.			

Loc. in Sec. SE SW NE  
 Geol. \_\_\_\_\_  
 Contr. Schafer  
 Pool Diebolt

**FIRST REPORT**  
 JUL 21 1954

Date Comm. \_\_\_\_\_  
 Location \_\_\_\_\_

\_\_\_\_\_

\_\_\_\_\_

\_\_\_\_\_

\_\_\_\_\_

\_\_\_\_\_

\_\_\_\_\_

\_\_\_\_\_

\_\_\_\_\_

Co.  
 Lse.  
 No.  
 Sec.  
 T.  
 R.

County Graham Elev. 2348  
 Sec. 33 Twp. 10S Rge. 23W  
 Company Imperial Drlg.  
 FarmName Diebolt No. 7

TOPS	DEPTH	LOG	DATUM	Loc. in Sec.
Anh.	1850			SE SW NE
TP.				
H.	3547		1199	
Tr.	3566		1218	
Dg.				
Bl.				
L.	3583		1235	
K.C.				Geol.
B.K.C.				Contr.
Ce.				Schafer
C.				
M.				Pool
M.				Diebolt
K.				
Mz.				
Me.				
V.				
S.				
S.				
A.				COMPLETE
R.				
PE.				
G.				
T.D.	3780			

Date Comm. 7-27-55 SEP 21 1955

8" 215 w/125; DST 3609-18 op 30" rec. 10'

mud, BHP 0# 20"; DST 3609-21 op 2 hrs.

20" rec. 166' gip, rec. 63' ocm, 60'

ocw, BHP 720# 20"; 5 1/2" 3780; fill 100'

oil no wtr. 30"; swb 1.68 boph no wtr.;

3000A; swb 21 boph no wtr. 3 hrs. 500' OB

24/3748-52; packer 3767; 3000 A; swb 28 boph

no wtr.; swb average 6.5 boph no wtr.;

Phy. pmp 209 bopd 10% wtr.