


Graham KANSAS

DX 78-1

Section 33 Township 10 Range 23W


Well No. 3 Diebolt

Company Imperial Drlg/g

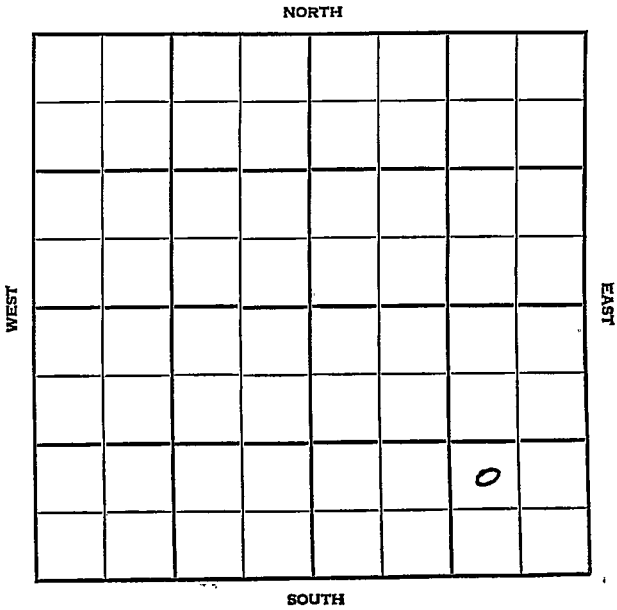



SEC.	TWP.	R.
33	10	23W
WELL NO.		
3 Diebolt		
COMPANY		FARM
Imperial Drlg.		
CONTRACTOR		

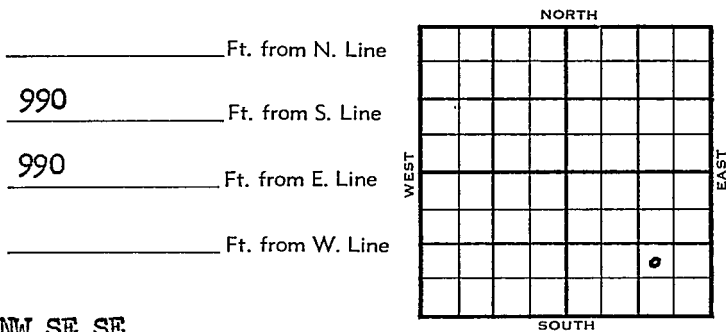

NW SE SE

	ELEVATION	REPORT
1954	2329	.

6/30	Spudding 6-23-54 8" @ 225 Drlg. 3427
7/7	Anhy 1822', Heeb 3539', Lans 3575' DST 3601-11, 1 hr., 2500' gas, 90' ocm, 325' oil, 900# RTD 3775' 5" @ 3775'
7/21	DD 3784' FU 850' oil 12 hrs. 3000 A 13 BOPH 8 hrs.
7/28	Spud 6-23-54 Oil well TD 2784 8" @ 225 Anhy 1822 Heeb 3539 Lans. 3575 DST 3601-11 open 1 hr rec 2500' gas, 90' OCM 325' oil 900# TD 3775 5" @ 3775 DD 3784 FU 850' oil 12 hr. 3000 A 13 BOPH 8 hr. Comp. 207 BOPD

COMPLETED

