


Section 33 Township 10 Range 20 W

Well No. #³/₂ C. E. Allphin

Company Continental Oil

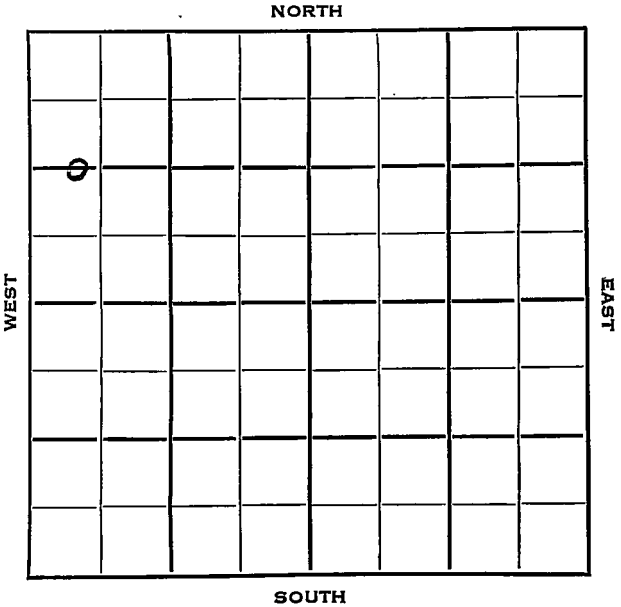

Rooks **KANSAS** ✓

Sec. 33 Twp. 10 R. 20W

Well No. #3
#2 C. E. Allphin Farm

Continental Oil Company

L & J Drlg. Contractor

Allphin Pool


1320 Ft. from N. Line

_____ Ft. from S. Line

_____ Ft. from E. Line

440 Ft. from W. Line

C $W\frac{1}{2}$ $W\frac{1}{2}$ NW

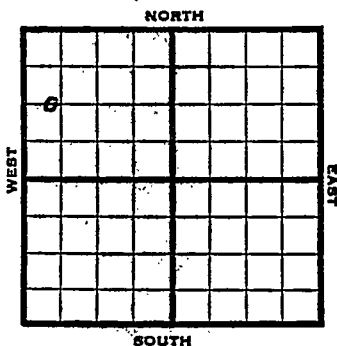

1953 Elev. 2173'

REPORT

5/13 Spud 5-11-53
Rng. surface pipe

5/21 Drlg. 3492'

5/27 Spud 5-11-53

D & A

TD 3840'

8" @ 263'

Anhy 1636', Top 3221, Heeb 3428,

Lans 3468, B KC 3686, Cong 3721

TD 3840'

D & A

ABANDONED

County Rooks State Kansas

Sec. 33 (Blk. Twp.) 10 (Sur. Rge.) 20W Map No.

Operator Continental Oil

Well No. 2 Farm C. E. Allphin

Elev. _____ Location C $\frac{1}{2}$ W $\frac{1}{2}$ NW

1320 Ft. From N Line NW

440 Ft. From W Line Quarter

Ist. Report MAY 13 1953

Completion _____

Remarks _____

L & J Drig. - Contr.

Spudding Date 5-11-53

Drig. Data Allphin Pool

rng. surface pipe

Map No. _____ Sec. 33 Twp. 10 R. 20W

Well No. 3 C. E. Allphin

_____ Continental Oil _____ Company

CORRECTION

Contractor _____

C $W\frac{1}{2}$ $W\frac{1}{2}$ NW

SECTION PLAT

1320 Ft. from N. Line

_____ Ft. from S. Line

_____ Ft. from E. Line

440 Ft. from W. Line

Rooks County

Location _____

Rig up _____

Drilling and Remarks:

Reported

#2

RECORD

Cased _____ in., _____ ft.

Sand _____

Gas _____

Oil _____

Total Depth _____

PRODUCTION

1st 24 hrs. Nat. _____

1st 24 hrs. after shot _____

Gas _____ Cu. Ft.

Dry Hole _____

Abandoned _____

Date

MAY 20 1953

19

J. G. McGEHEE

Scout

County _____ Rocks _____ State Kansas

Sec. 33 (Blk. Twp.) 10 (Sur. Rge.) 20W Map No.

Operator Continental Oil

Well No. 3 Farm C. E. Allphin

Elev. 2173 Location C W $\frac{1}{2}$ W $\frac{1}{2}$ NW

1320Ft. From N Line NW

440Ft. From W Line Quarter

Ist. Report

Completion MAY 27 1953

Remarks Allphin Pool

L & J Drlg. - Contr.

Spudding Date 5-11-53

Drlg. Data D & A TD 3840

8" @ 263 Anhy 1636 Top. 3221

Heeb. 3428 Lans. 3468 B KC 3686

Cong. 3721 TD 3840

D & A