


Section 33 Township 10 Range 20W

Well No. #7 C.E. Allphin

Company Continental Oil

NORTH

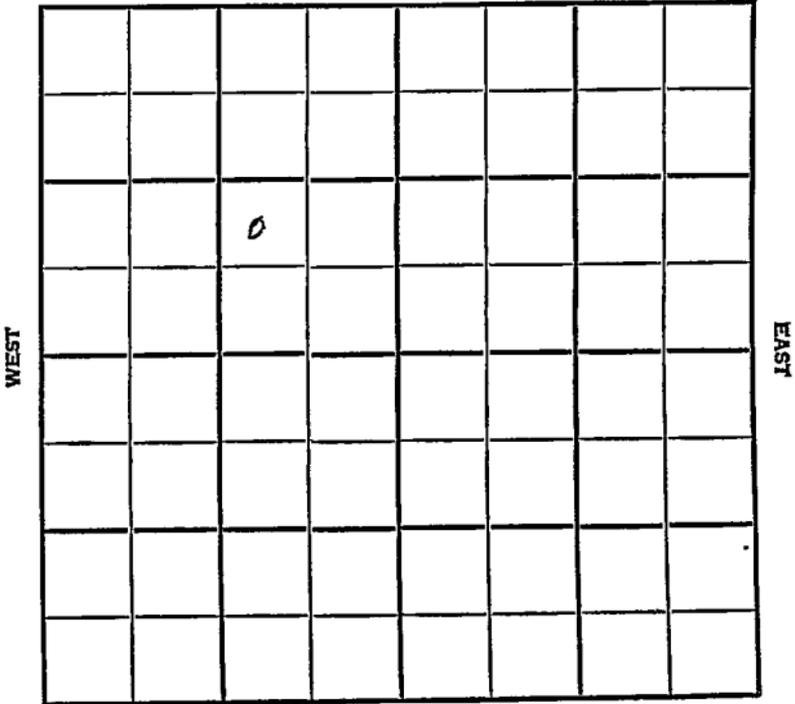

SOUTH

WEST

EAST

Rooks KANSAS


SEC. <b>33</b>	TWP. <b>10</b>	R. <b>20W</b>
-------------------	-------------------	------------------

WELL NO. **7 C. E. Allphin** FARM

COMPANY **Continental Oil**

CONTRACTOR **Lohman & Johnson**  
**Allphin Pool**

\_\_\_\_\_ Ft. from N. Line  
**990** \_\_\_\_\_ Ft. from S. Line  
**990** \_\_\_\_\_ Ft. from E. Line  
 \_\_\_\_\_ Ft. from W. Line

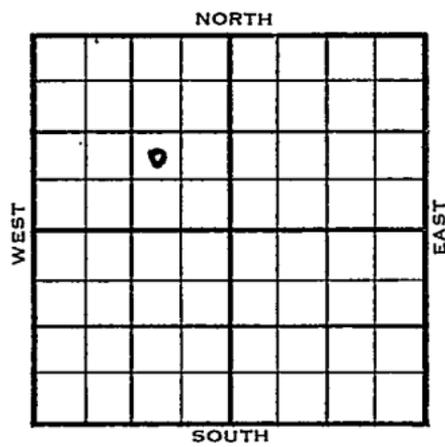

**NW SE NW**

	ELEVATION	REPORT
<b>1955</b>	<b>2160'</b>	
<b>2/16</b>		Spud 2-11-55 8" @ 255' Drlg. 2935'
<b>3/2</b>		Spud 2-11-55 Oil Well TD 3740' 8" @ 255' Top 3193' Heeb 3398' Tor. 3418' KC 3435' DST 3454'-3504' opn 1 hr, rec 80' Mud 1080# DST 3571'-3600' opn 1 hr, rec 60' hocm 360' mo 1220# DST 3610'-45' opn 1 hr, rec 280' mo 1170# B KC 3656' Cong. 3688' Simp 3703', Arb. 3728' TD 3732' 5" @ 3728' DD 3740' 500 A P/ 64 bo 8 hr. Comp 192 bopd.
		<b>COMPLETED</b>

County **Rooks** State **Kansas**

Sec. **33** (Blk. Twp.) **10** (Sur. Rge.) **20W** Map No.

Operator **Continental Oil**

Well No. **7** Farm **C. E. Allphin**

Elev. **2160** Location **NW SE NW**

	0				
FIRST REPORT					

990 Ft. From **S** Line **NW**

990 Ft. From **E** Line **Quarter**

1st. Report **FEB 1 6 1955**

Completion

Remarks

**Lohman & Johnson - Contr.**

Spudding Date **2-11-55**

Drlg. Data **Allphin Pool**

**8" @ 255 drlg. 2935**

