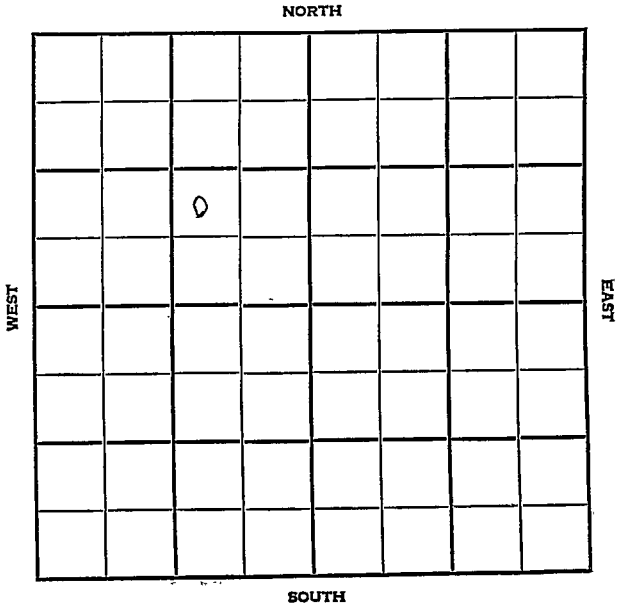


Graham

KANSAS

DX 78-1

Section 33 Township 10 Range 21WWell No. #1 NoahCompany Petroleum Inc.

Graham

KANSAS

SEC.	TWP.	R.
33	10	21 W

WELL NO.

1 Noah FARM

COMPANY

Petroleum Inc.

CONTRACTOR

Garvey


Wildcat
Ft. from N. Line

990 Ft. from S. Line

990 Ft. from E. Line

Ft. from W. Line

NW SE NW

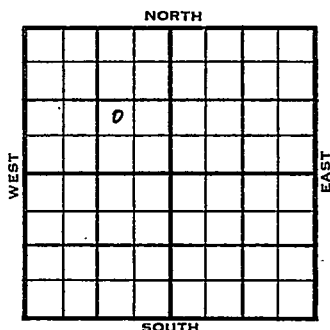

	ELEVATION	REPORT
1954	2161'	

9/8 RUR
 10/27 Spud 9-754 - Oil Well
 TD 3830'
 8-5/8" @ 209'
 Anhy 1658', Heeb 3418', Tor 3442',
 L ans 3458'
 DST 3710-66', opn 1 hr., rec. 30'
 gas, 340' HO&GCM, 925#
 Simp. 3795', Arb. 3799'
 TD 3830'
 5" @ 3825'
 CO to 3780'
 24/3756-64, B/3 go 3 gwph 2 hrs.,
 250 M-A
 S/2 bf 20% wtr. A-frac, 1000A
 S/7 bfph 30% wtr.
 Marm. 3697'
 Comp. 103 bopd 15% wtr.

COMPLETED

County Graham State KansasSec. 33 (Blk.) 10 (Sur. Rge.) 21W Map No.Operator Petroleum Inc.Well No. 1 Farm NoahElev. Location NW SE NW

FIRST REPORT

990 Ft. From S Line NW990 Ft. From E Line Quarter1st. Report SEP. 8 1954

Completion

Remarks


Garvey - Contr.

Spudding Date

Drlg. Data WildcatR U R

FABEN GILSTRAP

County Graham State Kansas
 Sec. 33 (Blk.) 10 (Sur.) 21W Map No. _____
 Operator Petroleum Inc.
 Well No. 1 Farm Noah
 Elev. 2161 Location NW SE NW

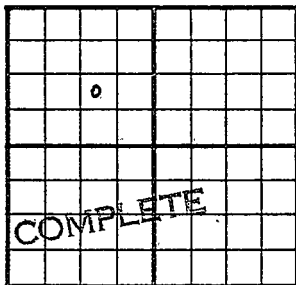

990 Ft. From S Line NW
 990 Ft. From E Line Quarter
 1st. Report _____
 Completion OCT 27 1954
 Remarks Wildcat
Garvey - Contr.
 Spudding Date 9-7-54

Drlg. Data Oil well TD 3830
8 5/8" @ 209 Anhy 1658 Heeb. 3418
Tor. 3442 Lans. 3458 DST 3710-66
open 1 hr. Rec. 30' gas 340' ho & gcm
925# Simp. 3795 Arb. 3799 TD 3830
5" @ 3825 CO to 3780 24/ 3756-64
B/ 3 go 3 gwph 2 hr. 250 M-A S/ 2 bf
20% wtr. A-frac 1000 A S/ 7 bfph
30% wtr. Marm. 3697
Comp. 103 bopd 15% wtr.

FABEN GILSTRAP