

1-10-88 W Inc

STATE CORPORATION COMMISSION OF KANSAS
OIL & GAS CONSERVATION DIVISION
WELL COMPLETION OR RECOMPLETION FORM
ACO-1 WELL HISTORY
DESCRIPTION OF WELL AND LEASE

Operator: License # 6039
Name L.D. Drilling, Inc.
Address Route #1, Box 183-B
City/State/Zip Great Bend, KS 67530

Purchaser na

Operator Contact Person L.D. Davis
Phone 316-793-3051

Contractor: License # 5864
Name Lobo Drilling Co.
Kim Shoemaker

Wellsite Geologist
Phone 316-682-1537

Designate Type of Completion

☒ New Well ☐ Re-Entry ☐ Workover
☐ Oil ☐ SWD ☐ Temp Abd
☐ Gas ☐ Inj ☐ Delayed Comp.
☒ Dry ☐ Other (Core, Water Supply etc.)
If OWWO: old well info as follows:

Operator
Well Name
Comp. Date Old Total Depth

WELL HISTORY

Drilling Method:
☒ Mud Rotary ☐ Air Rotary ☐ Cable

10-25-86.. 10-27-86.. 10-27-86..
Spud Date Date Reached TD Completion Date

2740'..
Total Depth PBTD

Amount of Surface Pipe Set and Cemented at 374' feet
Multiple Stage Cementing Collar Used? ☐ Yes ☐ No
If yes, show depth set.....feet
If alternate 2 completion, cement circulated
from.....feet depth to.....w/.....SX cmt
Cement Company Name
Invoice #

API NO. 15-193-20,419

County Thomas

NW SE SE Sec 1 Twp 10 Rge 33 East
..... West

990 Ft North from Southeast Corner of Section
990 Ft West from Southeast Corner of Section

(Note: Locate well in section plat below)


Lease Name Kuska "J" Well # 2

Field Name

Producing Formation

Elevation: Ground 3088 KB 3093

Section Plat

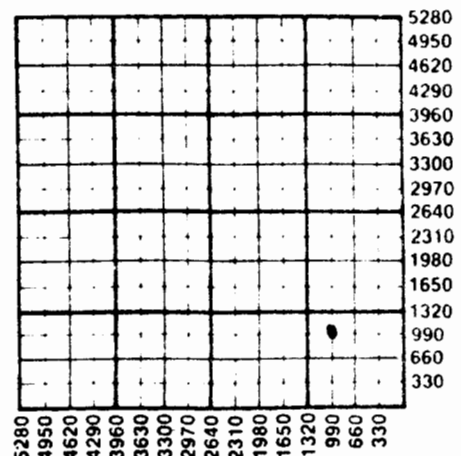

WATER SUPPLY INFORMATION

Disposition of Produced Water: ☐ Disposal
Docket # ☐ Repressuring

Questions on this portion of the ACO-1 call:

Water Resources Board (913) 296-3717

Source of Water:
Division of Water Resources Permit #

☒ Groundwater.....Ft North from Southeast Corner
(Well)Ft West from Southeast Corner of
Sec Twp Rge East West

Surface Water.....Ft North from Southeast Corner
(Stream, pond etc).....Ft West from Southeast Corner
Sec Twp Rge East West

Other (explain).....
(purchased from city, R.W.D. #)

INSTRUCTIONS: This form shall be completed in triplicate and filed with the Kansas Corporation Commission, 200 Colorado Derby Building, Wichita, Kansas 67202, within 120 days of the spud date of any well. Rule 82-3-130, 82-3-107 and 82-3-106 apply.

Information on side two of this form will be held confidential for a period of 12 months if requested in writing and submitted with the form. See rule 82-3-107 for confidentiality in excess of 12 months. One copy of all wireline logs and drillers time log shall be attached with this form. Submit CP-4 form with all plugged wells. Submit CP-111 form with all temporarily abandoned wells.

WES-01-1

SIDE TWO

79649

Operator Name L.D. Drilling, Inc. Lease Name Kushka "J" Well # 2

Sec. 1 Twp. 10 Rge. 33 ☐ East ☒ West County Thomas

WELL LOG

INSTRUCTIONS: Show important tops and base of formations penetrated. Detail all cores. Report all drill stem tests giving interval tested, time tool open and closed, flowing and shut-in pressures, whether shut-in pressure reached static level, hydrostatic pressures, bottom hole temperature, fluid recovery, and flow rates if gas to surface during test. Attach extra sheet if more space is needed. Attach copy of log.

Drill Stem Tests Taken ☐ Yes ☒ No
 Samples Sent to Geological Survey ☐ Yes ☐ No
 Cores Taken ☐ Yes ☐ No

Formation Description
☒ Log ☐ Sample

Name	Top	Bottom
Anhy	2617	2643

Anhy was low to #1 well and it was decided to plug.

CASING RECORD ☐ New ☒ Used

Report all strings set-conductor, surface, intermediate, production, etc.

Purpose of String	Size Hole Drilled	Size Casing Set (In O.D.)	Weight Lbs/Ft.	Setting Depth	Type of Cement	#Sacks Used	Type and Percent Additives
Surface	12 1/2"	8-5/8"	32#	374'	60/40poz	200	2% gel 3% cc

PERFORATION RECORD

Shots Per Foot Specify Footage of Each Interval Perforated

Acid, Fracture, Shot, Cement Squeeze Record (Amount and Kind of Material Used) Depth

Shots Per Foot	Specify Footage of Each Interval Perforated	Acid, Fracture, Shot, Cement Squeeze Record (Amount and Kind of Material Used)	Depth

TUBING RECORD

Size

Set At

Packer at

Liner Run

☐ Yes ☐ No

Date of First Production Producing Method

☐ Flowing ☐ Pumping ☐ Gas Lift ☐ Other (explain).....