


Map No. Ashtone Sec. 34 Twp. 10 R. 15 ^WWell No. 1 - Wiley FarmCompany Suggitt et al

NORTH

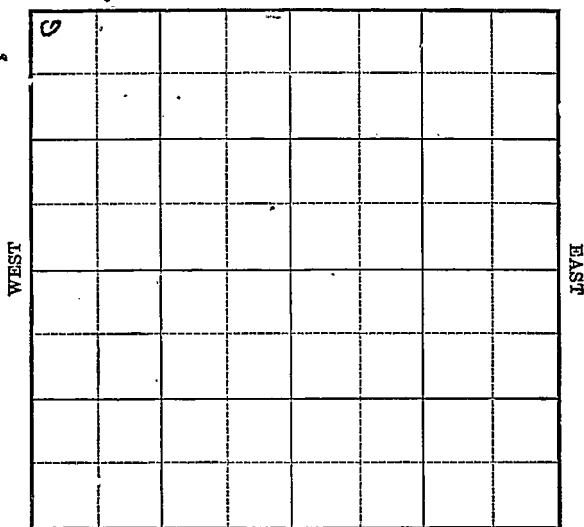

SOUTH

Location _____

Drilling Remarks:

Rig Up _____

Drilling Remarks:

RECORD

Cased _____ in. _____ ft.

Sand _____

Gas _____

Oil _____

Total Depth _____

PRODUCTION

1st 24 hrs. Nat. _____

1st 24 hrs. after shot _____

Gas _____ cu. ft.

Dry Hole _____

Abandoned _____

Map No. K Sec. 34 Twp. 10 R. 15 W


Well No. 1 - Wierley Farm
Leggett Et al Company

200 Ft. from N. Line

_____ Ft. from S. Line

_____ Ft. from E. Line

200 Ft. from W. Line

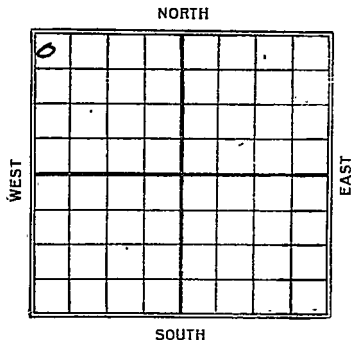

1924

REPORT

4/9 Hly 450'

4/24 Hly 715'

5/10 15" - 790

12 1/2 - 1085

Hly 1230

4/20 - 2430

11/23 S. & Q. 3600'

Asborne Co
 Map No. *11 Map* Sec. *34* Twp. *10* R. *15 W*

Well No. *#11 Werley*

Liggitt & Co Company

Contractor

FIRST REPORT

SECTION PLAT

200' Ft. from N. Line

_____ Ft. from S. Line

_____ Ft. from E. Line

200' Ft. from W. Line

<i>6</i>			

Location _____

Rig up _____

Drilling and Remarks:

Wdg. 450'

RECORD

Cased _____ in., _____ ft.

Sand _____

Gas _____

Oil _____

Total Depth _____

PRODUCTION

1st 24 hrs. Nat. _____

1st 24 hrs. after shot _____

Gas _____ Cu. Ft.

Dry Hole _____

Abandoned _____

Date

APR 9 1924

M. A. BENEAR

192

Scout

Liggitt Lines in Rasalia
Kans.

MAP NO. _____ SEC. 32 TWP. 10S R. 15WWELL NO. 1 WronleyReport at al COMPANY _____

CONTRACTOR _____

SECTION PLAT

_____ FT. FROM N. LINE

_____ FT. FROM S. LINE

_____ FT. FROM E. LINE

_____ FT. FROM W. LINE

RECORD

LOCATION _____

CASED _____ IN. _____ FT.

RIG UP _____

SAND _____

DRILLING AND REMARKS:

GAS _____

OIL _____

TOTAL DEPTH 3602

PRODUCTION

1ST 24 HRS. NAT. _____

1ST 24 HRS. AFTER SHOT _____

GAS _____ CU. FT.

DRY HOLE ✓ABANDONED ✓

DATE

9/18 192 ✓ SCOUT

Map No. KANSAS Sec. 34 Twp. 10 R. 15W

Well No. 1 Werler

Luggett et al Company

Contractor

ABANDONED

SECTION PLAT

200 Ft. from N. Line

_____ Ft. from S. Line

_____ Ft. from E. Line

200 Ft. from W. Line

0	F	correct	1

Location _____

Rig up _____

Drilling and Remarks:

LOT 9
3600'

RECORD

Cased _____ in., _____ ft.

Sand _____

Gas _____

Oil _____

Total Depth _____

PRODUCTION

1st 24 hrs. Nat. _____

1st 24 hrs. after shot _____

Gas _____ Cu. Ft.

Dry Hole _____

Abandoned _____

Date

NOV 23 1924

M. A. BENEAR

192

Scout