


Section 34 Township 10 Range 16-W

Well No. #1 O'Leary

Company L L Hartman

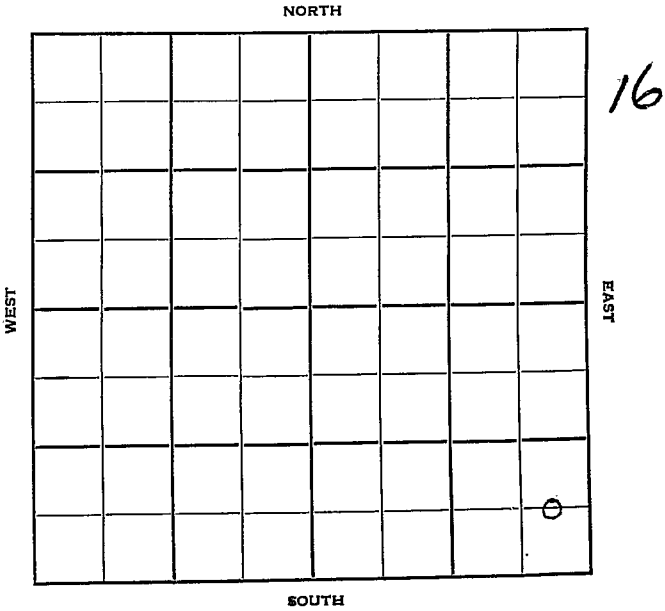

Sec. 34 Twp. 10 R. 16W

Well No. #1 O'Leary Farm

W.L. Hartman Company

Krueger Pool Contractor


_____ Ft. from N. Line

660' Ft. from S. Line

330' Ft. from E. Line

_____ Ft. from W. Line

C E L S E S E

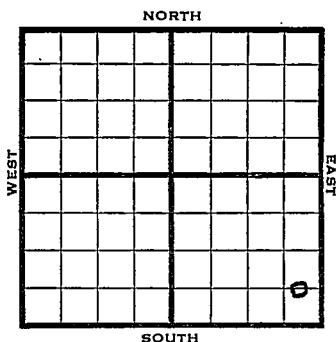

1950 Elev. 2072' REPORT

8/16 Location

1951
1/17
Spud 8-13-50
Oil Well TD 3575
8" @ 166' Heeb. 3194
Toronto 3215' Lans. 3238
DST 3218-30 opn 1/2 hr
Rec. 20' mud sso DST 3290-3324
opn 1/2 hr Rec. 32' mud & wtr
DST 3325-50 opn 20 min Rec. 450'
muddy sw DST 3352-75 opn 30 min
Rec. 20' mud DST 3377-3400 opn 1/2 hr
Rec. 90' hocm DST 3405-36 opn 1/2 hr
Rec. 15' ocm DST 3436-67 opn 1/2 hr
Rec. 5' mud DST 3477-3507 opn 1/2 hr
Rec. 10' ocm Arb. 3560
DST 3560-65 opn 1 hr Rec. 63' hocm
TD 3565 5" @ 3564 GO to 3565
200 A FU 200' oil 375' wtr 10 hr
DD 3567 DD 3574
FU 500' oil 300' wtr 2000 A @ 3532
500 A FU 1150' oil 200' wtr
TD 3575 FU 1400' oil 200' wtr
SP 3520 500 A HFW SP 3304
23/3454-60 500 A FU 150' oil
1750' wtr 8 hr PB 3309
117/3280-3304 1500 A FU 750' wtr
5' oil 12 hr PB 3278
5/3264-70 18/3263-69 B/3 bf SSO

OVER

1951

(Information brought forward)

1/17

18/3173-83 DC 3450
82/3368-86 1000A FU 1800'
wtr 5' oil 12 hr PB 3236
63/3210-24 1000 A FU 760' fluid
700' oil 60' wtr S/4 boph 700'
oil 10' wtr S/6 boph
Comp. 78 bopd

COMPLETED

Drig. Data

FU 500' oil 300' water 2000 A @ 3532

500' A FU 1150' oil 200' water TD 3575

FU 1400' oil 200' water SP 3520, 500 A

HFW. SP 3304 23/ 3454-60 500 A

FU 150' oil 1750' water 8 hr. PB 3309

117/ 3280-3304 1500 A FU 750' water

5' oil 12 hr. PB 3278 5/ 3264-70

18/ 3263-69 B/ 3 bf SSO. 18/ 3173-83

DC 3450 82/ 3368-86 1000 A FU 1800'

water 5' oil 12 hr. PB 3236 63/ 3210-24

1000 A FU 760' fluid 700' oil 60' water

S/ 4 boph 700' oil 10' water S/ 6 boph

Comp. 78 bopd

.....	Misc
.....	Pierce Map
.....	France Map
.....	Tracings
.....	Land Wall Map
.....	Land Small Ma
.....	Scout Cards

[Handwritten signature/initials over the form]

1951-22-1951