


Section 34 Township 10 Range 17 W

Well No. # 1 Brummitt

Company J. F. Darby

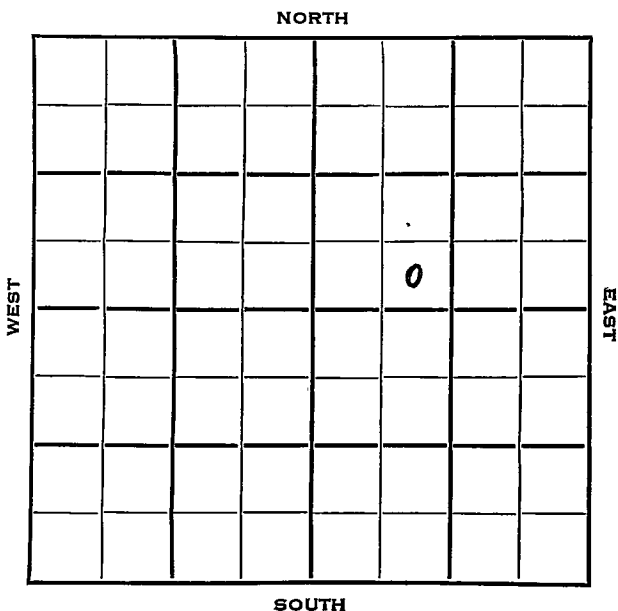

Rooks

KANSAS

SEC.	34	TWP.	10	R.	17W
------	----	------	----	----	-----

WELL NO.

#1 Brummitt

FARM

COMPANY

J.F. Darby

CONTRACTOR

Iron Drlg.
Wilcoat

Ft. from N. Line


330

Ft. from S. Line

Ft. from E. Line

990

Ft. from W. Line

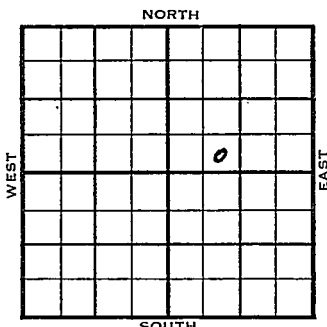SE SW NE
Lion - DHM

1953

ELEVATION

1914'

REPORT

10/28

R U R

11/4

8" @ 163 w/100

Top 2836 Heeb 3064'

11/11

Cong. 3387'

DST 3379-3404, 1 hr, 12' M, 300# 15"

Arb. 3475'

DST 3477-81, 1 hr, 120' HOCM 1100# 20"

RTD 3483 Schl 5" @ 3477

11/18

NR

12/16

Spud 10-26-53 Oil well TD 3483

8" @ 163 Top. 2836 Heeb 3064'

Tor. 3084 Lans. 3107'

DST 3196-3213 open 1 hr, 40 min,

rec 210' wtr. 890# Cong. 3387

DST 3379-3404, open 1 hr. rec 12' mud

300# Arb. 3475'

DST 3477-81, open 1 hr rec 120' HOCM

1100# TD 3483 5" @ 3477 FU 200'

oil 1 hr. CO to 3483 FU 450' oil

55 A S/3 BOPH inc. to 5 1/2 BOPH

P/82 BO 24 hr.

Comp. 123 BOPD

COMPLETED


Sec. 34 (Blk. 10 Twp. 17W) (Sur. 17W) Map No. _____

Operator J. F. Darby

Well No. 7 Farm Brummitt

Elev.	Location	SE	S ^{1/4}	NE
-------	----------	----	------------------	----

0

FIRST REPORT

330 Ft. From S Line NE

990 Ft. From W Line Quarter

1st. Report OCT 28 1953

Completion

Remarks Lion - DEM

Iron Dwg. - Contr.

Spudding Date _____

Drlg. Data **Wildcat**

RUR

G. McGEHEE

J. G. McGEHEE