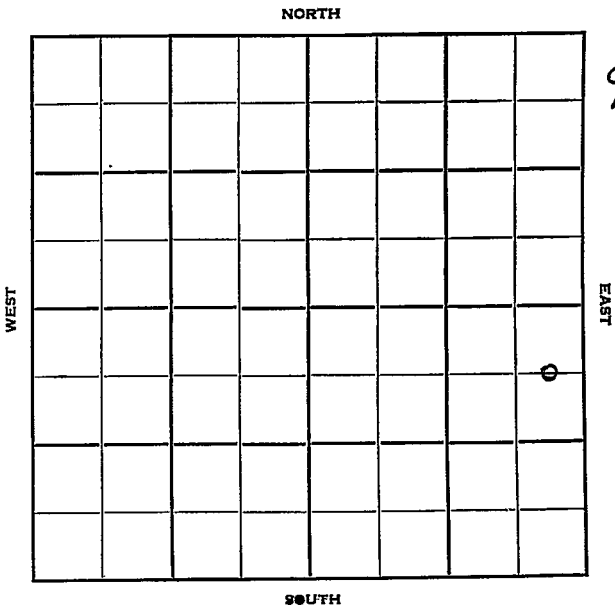


Section 34 Township 10 Range 16WWell No. #2 O'LearyCompany W. L. Hartman

Rooks

Sec. 34 Twp. 10 R. 16W ✓

Well No. #2 O'Leary Farm

W. L. Hartman Company

Contractor

Kruger Pool


660 Ft. from N. Line

 Ft. from S. Line

330 Ft. from E. Line

 Ft. from W. Line


C E L NE SE

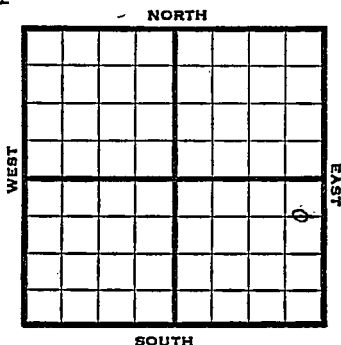

1951 Elev. - REPORT

11/21 8" @ 165
1952
1/30 8" @ 165'
Location abandoned

ABANDONED

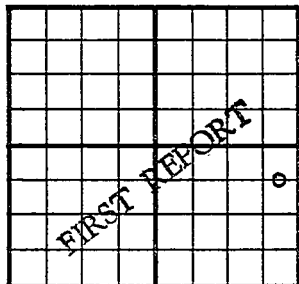
County Rooks State KansasSec. 34 (Blk. Twp.) 10 (Sur. Rge.) 16W Map No.Operator W. L. HartmanWell No. 2 Farm O'LearyElev. Location C E L NE SE660 Ft. From N Line SE330 Ft. From E Line Quarter1st. Report NOV 21 1951

Completion

Remarks

Spudding Date

Drlg. Data Kruger Pool8" @ 165

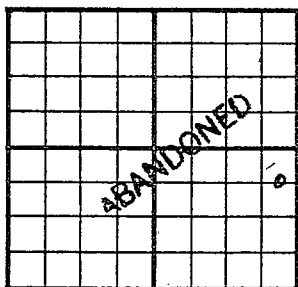County _____ Rooks _____ State KansasSec. 34 (Blk. Twp.) 10 (Sur. Rge.) 16W Map No. _____Operator W. L. HartmanWell No. 2 Farm O'LearyElev. _____ Location C E L N E S E660 Ft. From N Line SE330 Ft. From E Line Quarter

1st. Report _____

Completion JAN 30 1952Remarks Krueger Pool

Spudding Date _____

Drilg. Data _____

8" @ 165 Loc. abd.

J. G. McGEHEE