

KANSAS

Rooks

FORM 51 IOM 12-46 PETROL

Section 34 Township 10 Range 19-W

Well No. 1 Aksanit

Company A. D. Allison

Johnson Pool

NORTH

							0

WEST

EAST

SOUTH

KANSAS

Rooks
10

19N

Sec. 34 Twp. _____ R. _____

Well No. #1 Aksanit Farm _____

A.D. Allison Company _____
Johnson Pool


330 Ft. from N. Line

_____ Ft. from S. Line

330 Ft. from E. Line

_____ Ft. from W. Line

Ne SE

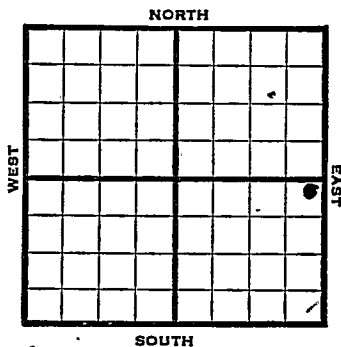

1947	Elev. 2118' REPORT
10/8	Location
10/15	RUR
10/22	8" @ 169' Drlg. 2117'
10/29	Topeka 3060' Drlg. 3270'
11/5	Lansing 3318' Arbuckle 2364' TD 3683' 5" @ 3393' RUST
11/12	Arbuckle 3648' Total Depth 3683' ABANDONED

Map No. _____ Sec. 34 Twp. 10 R. 19W

Well No. 1 Aksanit

A. D. Allison Company

FIRST REPORT

Contractor

NE SE

SECTION PLAT

330 Ft. from N. Line

_____ Ft. from S. Line

330 Ft. from E. Line

_____ Ft. from W. Line

Rooks County

Location X

Rig up _____

Drilling and Remarks:

RECORD

Cased _____ in., _____ ft.

Sand _____

Gas _____

Oil _____

Total Depth _____

PRODUCTION

1st 24 hrs. Nat. _____

1st 24 hrs. after shot _____

Gas _____ Cu. Ft.

Dry Hole _____

Abandoned _____

Date

OCT 8 1947

19

S. J. LEWIS Scout

Map No. 65 Sec. 34 Twp. 10 R. 19W

Well No. 1 Aksamit

A. D. Allison Company

ABANDONED

Contractor

NE SE

21.2118

SECTION PLAT

330 Ft. from N. Line

_____ Ft. from S. Line

330 Ft. from E. Line

_____ Ft. from W. Line

			o

Rooks County

Location _____

Rig up _____

Drilling and Remarks:

CR 13648

RECORD

Cased _____ in., _____ ft.

Sand _____

Gas _____

Oil _____

Total Depth *3683*

PRODUCTION

1st 24 hrs. Nat. _____

1st 24 hrs. after shot _____

Gas _____ Cu. Ft.

Dry Hole _____

Abandoned _____

Date

NOV 12 1947 19 _____

S. J. LEWIS Scout