


Section 34 Township 10 Range 20WWell No. #1 HarlanCompany Barnett Drlg.

NORTH

WEST

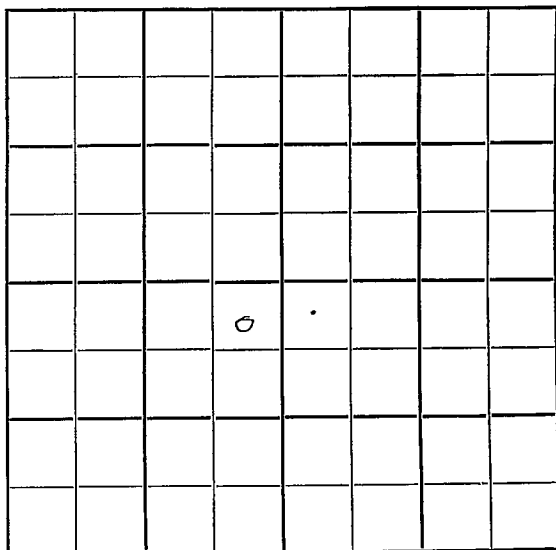

EAST

SOUTH

Rooks

KANSAS

Sec. 34 Twp. 10 R. 20 W

Well No. # 1 Harlan Farm

Barnett Drlg. Company

Contractor

Wildcat

330 Ft. from N. Line


 Ft. from S. Line

330 Ft. from E. Line

 Ft. from W. Line

NE NE SW

Derby Oil & Sunray Oil
support

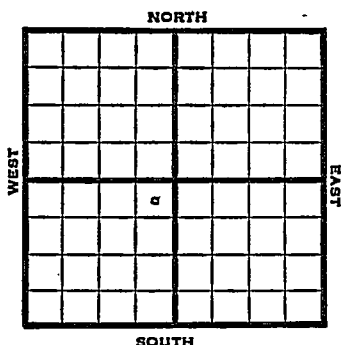

1951

Elev. 2090' REPORT


9/5

Spud 9-2-51
8" @ 147' WOC


9/19

Spud 9-2-51
D & A TD 3720' 8" @ 147
Anhy 1537' Heeb 3344' Lans 3382'
DST 3447-85 open 1 hr. rec 150' SW
B KC 3595' Cong. 3638' Simp. 3679'
Arb. 3693'
DST 3690-3712 open $\frac{1}{2}$ hr. rec 750' wtr.
TD 3720' D & A

ABANDONED

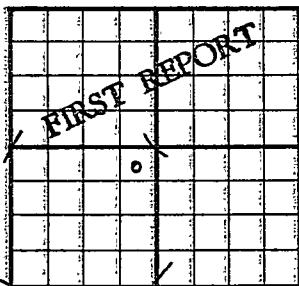County Rooks State KansasSec. 34 (Blk.) 10 (Sur.) 20W Map No.
(Twp.) (Rge.)Operator Barnett Drlg.Well No. 1 Farm HarlanElev. Location NE NE SW330 Ft. From N Line SW330 Ft. From E Line Quarter1st. Report SFP 5 1951Completion Remarks Derby Oil & Sunray
supportSpudding Date 9-2-51Drlg. Data Wildcat8" @ 147 WOC

J. E. TYRA

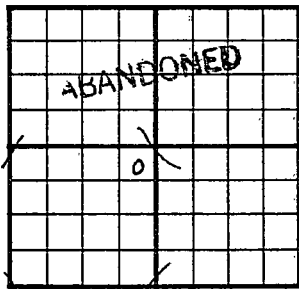County _____ Rooks _____ State KansasSec. 34 (^{Blk.}_{Twp.}) 10 (^{Sur.}_{Rge.}) 20W Map No. _____Operator Barnett Drlg.Well No. 1 Farm HarlanElev. 2090 Location NE NE SW330 Ft. From N Line SW330 Ft. From E Line Quarter

1st. Report _____

Completion SEP 19 1951Remarks WildcatSpudding Date 9-2-51Drlg. Data D & A TD 37208" @ 147 Anhy 1537 Heeb. 3344Lans. 3382 DST 3447-85 open 1 hr.Rec. 150' sw B KC 3595 Cong. 3638Simp. 3679 Arb. 3693 DST 3690-3712open $\frac{1}{2}$ hr. Rec. 750' water TD 3720D & A