


KANSAS

DX 78-1 Rooks

Section 34 Township 10 Range 20W

Well No. #2 Harlan

Company Barnett Drlg.

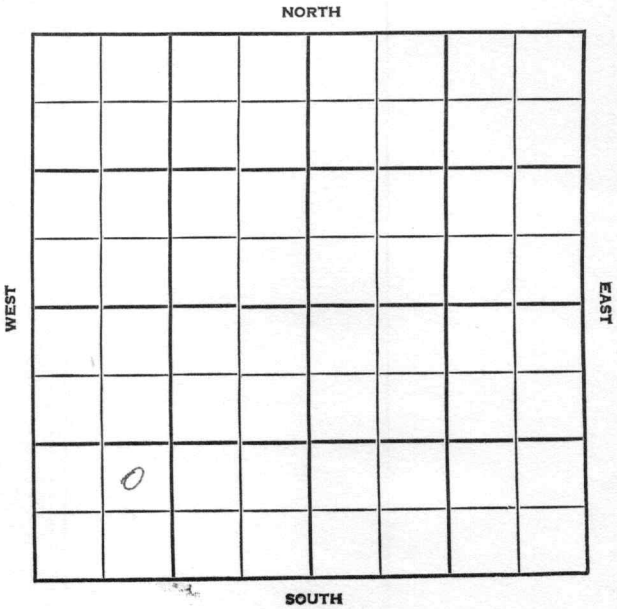


SEC. 34	TWP. 10	R. 20W
------------	------------	-----------

WELL NO. #2 Harlan FARM

COMPANY Barnett Drlg.

CONTRACTOR Co. Tools

_____ FT. FROM N. LINE
 _____ FT. FROM S. LINE
 _____ FT. FROM E. LINE
 _____ FT. FROM W. LINE

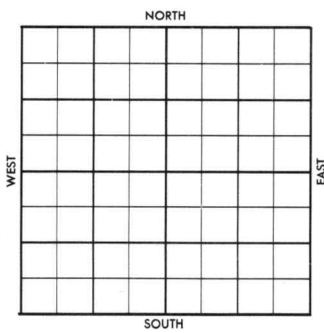

NE SW SW

1956	ELEVATION 2154'	REPORT
------	--------------------	--------

5-29 Comm. 5-22-56
 8" @ 175 w/125
 Drlg. 3385

6-6 DST 3510-53 op 90 min. rec. 55' M & W
 4' HOCM, BHP 1120/30".
 DST 3747-50 op 45 min. rec. 15' mud,
 BHP 1000#,
 D & A
 Anh. 1600', H. 3397', L. 3435',
 BKC 3648', Cgl. 3690', A. 3746'.
 TD 3765'

ABANDONED

County Rocks Elev. 2154
 Sec. 34 Twp. 10 Rge. 20W
 Company Barnett Drig.
 FarmName Harlan No. 2

TOPS	DEPTH	LOG	DATUM	Loc. in Sec.
Anh.	1600			NE SW SW
Tr.				
H.	3397			
Tr.				
Dg.				
Bl.				
L.	3435			
K.C.				Geol.
B.K.C.	3643			Contr.
Ce.	3690			Co. tools
C.				
M.				Pool
M.				
K.				
Mz.				
Ma.				
V.				
S.				
S.				
A.	3746			<div style="border: 1px dashed black; padding: 5px; text-align: center;"> ABANDONED 0 </div>
R.				
PE.				
G.				
TD.	3765			

Date Comm. 5-22-56 JUN 6 1956
8" @ 175/125 drls. 3385 JUN 6 '56
DST 3510 - 53 (40) rec 55' M + W
4' HOUM BHP 1120 (30)
DST 3747 - 50 (45) rec 15' M
BHP 1000 TD 3765
D & A