


Section 34 Township 10 Range 20W

Well No. #1 Rossman

Company D. G. Hansen

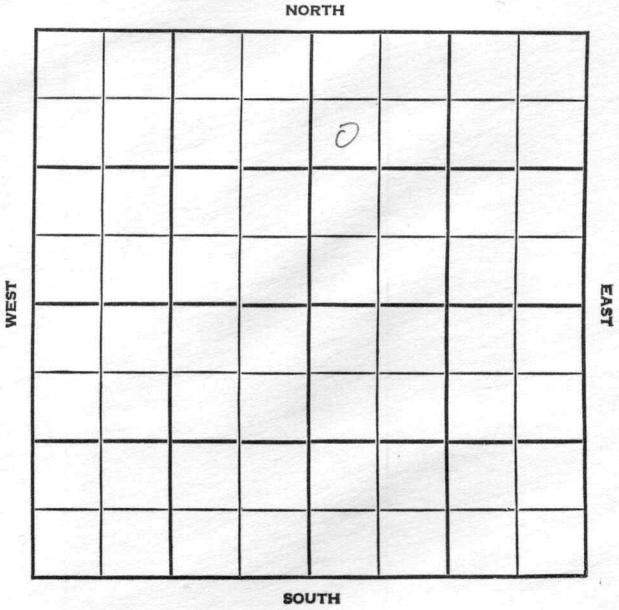

Rooks

KANSAS

SEC. 34	TWP. 10	R. 20W
------------	------------	-----------

WELL NO. #1 Rossman FARM

COMPANY D.G. Hansen

CONTRACTOR C & G Drlg.

Marcotte


_____ FT. FROM N. LINE

_____ FT. FROM S. LINE

_____ FT. FROM E. LINE

_____ FT. FROM W. LINE

SW NW NE

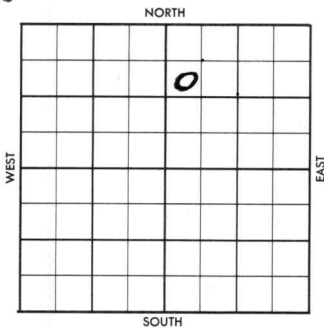

1956	ELEVATION 2111'	REPORT
------	--------------------	--------

7-18 MIR

8-1

Comm. 7-16-56
 8 5/8" @ 158 w/120
 DST 3705-10 op 1 hr, rec. 12' mud,
 760/20".
 D & A
 H. 3363'; Tr. 3385'; L. 3401';
 BKC 3614'; C. 3653'; S. 3686';
 A. 3703';
 TD 3725'

ABANDONED

County Rooks Elev. _____
 Sec. 34 Twp. 10 Rge. 20W
 Company D. G. Hansen
 Farm Name Rossman No. 1

TOPS	DEPTH	LOG	DATUM
Anh.			
TP.			
H.			
Tr.			
Dg.			
Bl.			
L.			
K.C.			
B.K.C.			
Ce.			
C.			
M.			
M.			
K.			
Mz.			
Mo.			
V.			
S.			
S.			
A.			
R.			
PE.			
G.			
FD.			

Loc. in Sec. SW NW NE
 Geol. _____
 Contr. C & G Drlg.
 Pool Marcotte



Date Comm. M I R JUL 18 '56

JUL 2 1956

R. G.

Co.
Lse.
No.
Sec.
T.
R.


TOPS	DEPTH	LOG	DATUM	Loc. in Sec.
Anh.				SW NW NE
TP.				
H.	3363			
Tr.	3385			
Dg.				
Bl.				
L.	3401			Geol.
M.C.				Contr.
B.K.C.	3614			C & G Drls.
Ce.				
C.	3653			
M.				Pool
M.				Marcotte
K.				
Mz.				
Mo.				
V.				
S.	3686			
S.				
A.	3703			
R.				
PE.				
G.				
T.D.	3725			

ABANDONED

Date Comm. AUG 1 1956
M I R JUL 25 '56 7-16-56 8 7/8 158
1120 @ 3506 AUG 1 '56 DST 3705-10
1hr rec 12' Md 760/20"

D&A