

Sec. 35 Twp. 10 Range 10W

Kansas Geological Society


Scout Tickets

Well # 1

Map No. Kansas Sec. 35 Twp. 10 R. 10 W.

Well No. 1 Farm

Red Bank Oil Company

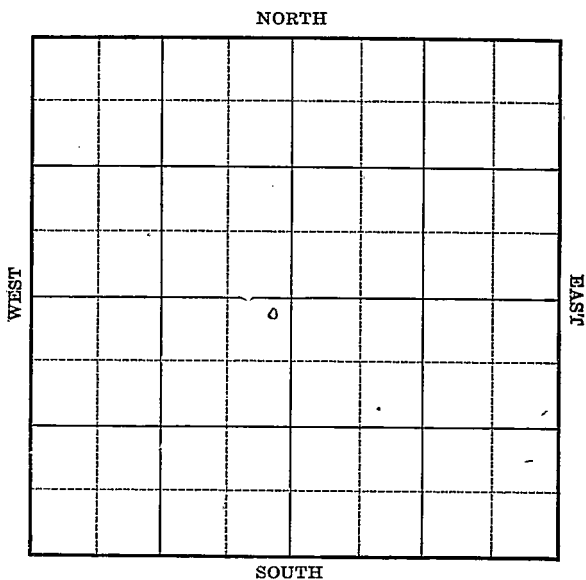

11

Location _____

Drilling Remarks _____

Rig Up _____

Drilling Remarks _____
_____ TD 313 _____

RECORD

Cased _____ in. _____ ft.

Sand _____

Gas _____

Oil _____

Total Depth _____

PRODUCTION

1st 24 hrs. Nat. _____

1st 24 hrs. after shot _____

Gas _____ cu. ft.

Dry Hole _____

Abandoned _____


Lincoln

Map No. Kansas Sec. 35 Twp. 10 R. 10^W

Well No. 1 Farm

Red Bank Oil Company

200 Ft. from N. Line
 _____ Ft. from S. Line
200 Ft. from E. Line
 _____ Ft. from W. Line

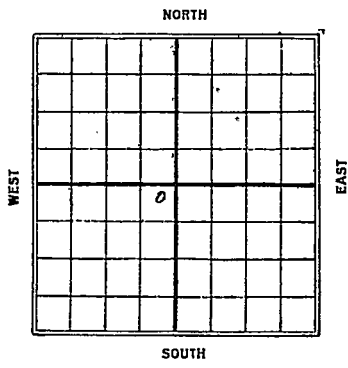

Date	REPORT
1926	
3/17	Location
4/17	Rig Bldg.
4/21	Rig
4/29	Spud.
5/5	—
5/26	drlg. 400
6/2	T.D. 504 S.D. repair boiler
6/16	D.lg. 1550'
6/23	" 1885'
6/30	Set an 8" @ 2336
7/14	same
7/21	T.D. 2680 4 R. 8"
8/11	T.D. 2900 - S.D. for pipe
8/19	running 6" 3000'
8/25	T.D. 3000 fishing tools.
8/31	T.D. 3040 U.R. 6"
9/8	T.D. 3040 - U.R.
9/15	—
9/22	Drlg 3315'
9/29	no report
10/6	U.R. 6" T.D. 3350
10/13	Drlg 3475'

10/18 - measured by Lewis
3513 barrels (Net)

10/20 - I.D. 3513 - 7"

10/27 - I.D. 3513 - 7"
D. & A.

Map No. *W map* **KANSAS** Sec. *25* Twp. *10* R. *10W*

Well No. *1*

Real Bank Oil Company

Contractor

SECTION PLAT

200 Ft. from N. Line

_____ Ft. from S. Line

200 Ft. from E. Line

_____ Ft. from W. Line

	0		

FIRST REPORTS

Location _____

Rig up _____

Drilling and Remarks:

Location must be spud by April 10th.

RECORD

Cased _____ in., _____ ft.

Sand _____

Gas _____

Oil _____

Total Depth _____

PRODUCTION

1st 24 hrs. Nat. _____

1st 24 hrs. after shot _____

Gas _____ Cu. Ft.

Dry Hole _____

Abandoned _____

Date

MAR 17 1926

S. J. LEWIS

Scout

MAP No. _____ SEC. 35 TWP. 10 S R. 10 W

WELL No. 1 Brown

Red Bank COMPANY

Howell CONTRACTOR

SECTION PLAT

		●	

_____ FT. FROM N. LINE

_____ FT. FROM S. LINE

_____ FT. FROM E. LINE

_____ FT. FROM W. LINE

RECORD

LOCATION _____

CASED _____ IN., _____ FT.

RIG UP _____

SAND _____

DRILLING AND REMARKS:

GAS _____

OIL _____

TOTAL DEPTH 3517

PRODUCTION

1ST 24 HRS. NAT. _____

1ST 24 HRS. AFTER SHOT _____

GAS _____ CU. FT.

DRY HOLE

ABANDONED

DATE

10/27 1926

SCOUT

Map No. 3 **KANSAS** Sec. 35 Twp. 10 R. 10 W

Well No. 1 Brown

Red Bank Oil Company

Contractor

SECTION PLAT

200 Ft. from N. Line

_____ Ft. from S. Line

200 Ft. from E. Line

_____ Ft. from W. Line

	o		

ABANDONED

Location _____

Rig up _____

Drilling and Remarks:

T 3513'-7"

D & A

RECORD

Cased _____ in., _____ ft.

Sand _____

Gas _____

Oil _____

Total Depth _____

PRODUCTION

1st 24 hrs. Nat. _____

1st 24 hrs. after shot _____

Gas _____ Cu. Ft.

Dry Hole _____

Abandoned _____

Date

OCT 27 1926

S. J. LEWIS Scout