


Section 35 Township 10 Range 15 W

Well No. #1 Worley

Company Musgrove Pet.

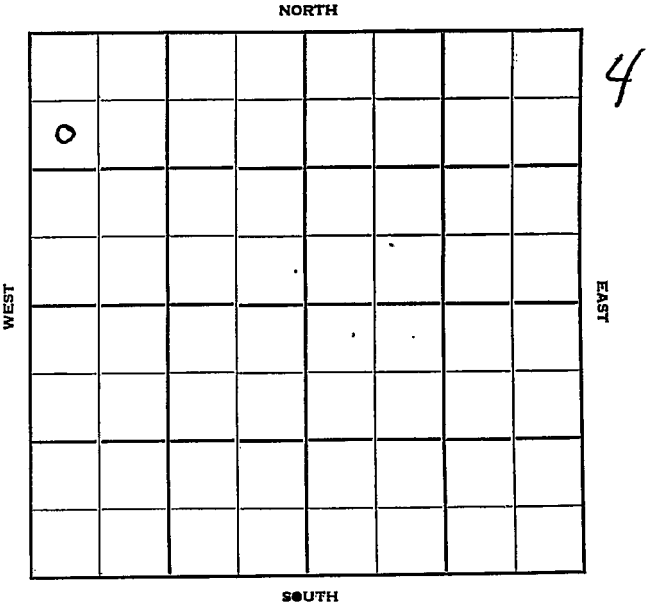

Osborne

KANSAS

Sec. 35 Twp. 10 R. 15W

Well No. #1 Worley Farm

Musgrove Pet. Company

Duke & Woods Contractor


Wildcat

990 Ft. from N. Line

_____ Ft. from S. Line

_____ Ft. from E. Line

330 Ft. from W. Line

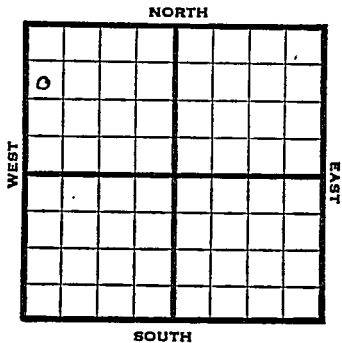

SW NW NW

Republic DHM

1952 Elev. 1757' REPORT

2/13 MIR

2/20 8" @ 228' Anhy 895'
Heeb 2916' Lans. 2972'
Drlg. 2976'

2/27 Spud 2-11-52
D&A TD 3544
8" @ 228
Anhy 895 Heeb. 2916
Lans. 2962 Arb. 3534
TD 3544 D&A

ABANDONED

County Osborne State Kansas

Sec. 35 (Blk. Twp.) 10 (Sur. Rge.) 15W Map No.

Operator Musgrove Pet.

Well No. 1 Farm Worley

Elev. _____ Location SW NW NW

0					

FIRST REPORT

990 Ft. From N Line NW

330 Ft. From W Line Quarter

Ist. Report FEB 13 1952

Completion _____

Remarks Republic -DEM

Duke & Woods - Contr.

Spudding Date _____

Drig. Data Wildcat

MIR

J. G. McGEHEE

