

Section 35 Township 10 Range 16-WWell No. #1 KruegerCompany Cities Service

NORTH

							0

WEST EAST

SOUTH

16

KANSAS

Rooks

Sec. 35 Twp. 10 R. 16W

Well No. #1 Krueger Farm

Cities Service Company

Wildcat


Ft. from N. Line

330' Ft. from S. Line

330' Ft. from E. Line

Ft. from W. Line

SE/C

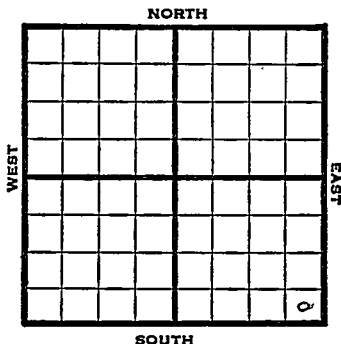

1948 Elev. 2084' REPORT

6/30	Drlg. 297'	
7/8	8" @ 297'	
	Drlg 3000	
7/14	Lansing 3255'	
	Drlg 3545' -	
7/21	Arbuckle 3649'	
	TD 3683'	
7/28	5" @ 3575'	
8/4	Perf. 32 shots 3537-44'	
	9 shots 3502-08'	
	23 shots 3444-55'	
	9 shots 3469-77'	
	18 shots 3423-29'	
	7000 acid	
	Swab 110 bbls. oil / 12 W.	
8/11	"	"
8/18	"	"
8/25	"	"
9/1	"	"
9/8	Lans 3255'	Arb 3649'
	5" @ 3575'	
	TD 3683'	
	Perf Lans.	
	2000 acid	
	Pump 905 oil & 13% W Pot.	
	Gr. 29°	

COMPLETED

Map No. _____ Sec. 35 Twp. 10 R. 16W

Well No. 1 Krueger


Cities Service Company

FIRST REPORT

Contractor

SE /C

SECTION PLAT

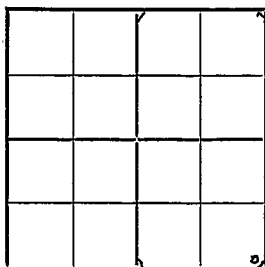

_____ Ft. from N. Line

330 Ft. from S. Line

330 Ft. from E. Line

_____ Ft. from W. Line

Rooks County

Location _____

Rig up _____

Drilling and Remarks:

drlg. 297

RECORD

Cased _____ in., _____ ft.

Sand _____

Gas _____

Oil _____

Total Depth _____

PRODUCTION

1st 24 hrs. Nat. _____

1st 24 hrs. after shot _____

Gas _____ Cu. Ft.

Dry Hole _____

Abandoned _____

Date

JUN 30 1948 19 S. J. LEWIS Scout

Rooks County Kansas State

Map No. 64 Sec. 35 Twp. 10 R. 16W

Well No. 1 Krueger

Cities Service Company

COMPLETE Contractor

SE/C

E12084
SECTION PLAT

 Ft. from N. Line

330 Ft. from S. Line

330 Ft. from E. Line

 Ft. from W. Line

							0

Krueger Pool

Remarks:

Lease 3255.

Ac 3649

5' @ 3575

NT 3653

Perf lease.

2000 acid

Pump 905 oil + 13% WOB

27th 84

Date

Scout

SEP 8 1948

S. J. LEWIS